


CERTIFIED RECORD OF LAND CORNER MONUMENTATION

History of original corner establishment:

Corner established by W. B. Barr under GLO contract no. 372 dated Sept. 10, 1880.

Surveyor General records state:

Marked basalt stone 16 x 10 x 5 for 1/4 sec corner.
Raised mound of rocks as per instructions.

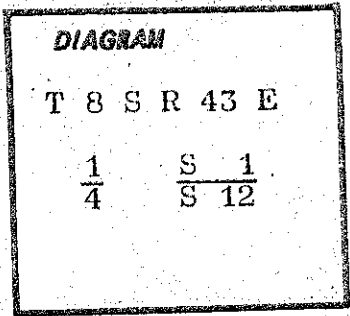

Description of corner evidence found:

Found a 16 x 6 x 5 stone firmly set with 1/4 marked on north face.
An existing dated fence line bears west 15 feet and runs north and south.

Description of monument and accessories | established to perpetuate the original location of this corner:

Set a 2½ inch brass cap on a 1 inch iron pipe 31 inches long and projecting 4 inches out of the ground with a surrounding rock mound.
Buried original stone alongside.

Brass cap marked thus: T 8 S R 43 E

$\frac{1}{4}$ $\frac{S \ 1}{S \ 12}$

CS 1981

I hereby certify that the above described corner was properly remonumented on Jan. 28, 1981, and witnessed by John Mitchell, Glen Weideman and Bill Hanley.

REGISTERED
PROFESSIONAL
LAND SURVEYOR

James D. Hanley
OREGON
SEPTEMBER 23, 1977
JAMES D. HANLEY
1206

Office of..... County of.....
State of....., I hereby certify that the within instrument was filed in this office
for record on the..... day of....., 19.....
..... by
(COUNTY OFFICIAL) (DEPUTY)