


CERTIFIED RECORD OF LAND CORNER MONUMENTATION

History of original corner establishment:

Corner originally established by W. Barr, under contract no. 372, dated 1880.

Marked basalt rock 18" x 16" x 10", from which;  
a pine 36" diameter bears S 50° E, 63 links distance  
Raised mound of rock.

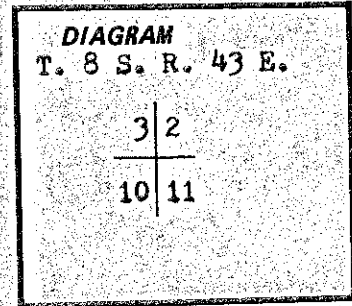

Description of corner evidence found:

Found no evidence of original stone.

Found 36" ponderosa pine, dead and down, S 50° E, 63 links. Scribing visible but badly weathered and unreadable.

Found 18" ponderosa pine, alive with healed face, N 43° E, 77 links (Record 72 links) set by Drake in 1919 retracement survey.

Found "X" chiseled on rock, N 44° W (Record N 34° W), 23 links, set by Drake in 1919.

Description of monument and accessories established to perpetuate the


original location of this corner: Set a 2½" x 30" aluminum pipe with a 3¼" aluminum cap, 21" in ground in mound of stone. Marked:

Bearing Trees

11" ponderosa pine, S 20° E, 23.5 ft., scribed "T. 8 S. R. 43 E. S11" in upper blaze and "BT" and brass tag stamped RLS 1664 in lower blaze.

6" ponderosa pine, S 25° W, 32.0 ft., scribed "T8S R43E S10" in upper blaze and "BT" and brass tag stamped RLS 1664 in lower blaze.

9" ponderosa pine, N 61° W, 63.6 ft., scribed "T8S R43E S3" in upper blaze and "BT" and brass tag stamped RLS 1664 in lower blaze.

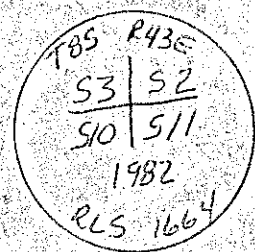

Compass declination 20° East

Note:

I set guard posts at corner with USFS 54-2 and 54-4 signs, placed USFS 54-3 and 54-4 signs on all bearing trees and painted a red band at breast height on smoothed bark on bearing trees.

I hereby certify the above corner location was perpetuated as herein described on June 2, 1982.

Terry Butler Terry Butler, Witness

Frank Vaughn Frank Vaughn, Witness

REGISTERED  
PROFESSIONAL  
LAND SURVEYOR

Carl E. Sundet  
OREGON  
JULY 14, 1978  
CARL E. SUNDET  
1664

Office of..... County of.....

State of..... I hereby certify that the within instrument was filed in this office

for record on the..... day of....., 19....

..... by .....

(COUNTY OFFICIAL)

(DEPUTY)

Form R6-7100-57 (9/71)

FILED JUNE 29, 1982

★ GPO—793-276

BAKER COUNTY SURVEYOR

SURVEY NO. 8-43-18