


CERTIFIED RECORD OF LAND CORNER MONUMENTATION

History of original corner establishment:

Corner originally established by W. Barr, under contract no. 372, dated 1880.

Marked basalt rock 15" x 10" x 6". Raised mound of rock.

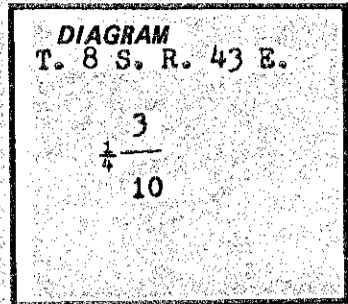

Description of corner evidence found:

No evidence of original corner.

Description of monument and accessories I established to perpetuate the original location of this corner: Set by proportionate measurement, an Aluminum pipe, 2 1/2" x 30", with a 3 1/4" aluminum cap, 24" in ground in mound of stone. Marked:

Bearing Tree

27" ponderosa pine, N 48° E, 189.2 ft., scribed "1/4 S3" in upper blaze and "BT" and brass tag stamped RLS 1664 in lower blaze.

Reference mound


4ft. x 4ft. mound of stone S 14° W, 14.0 ft.

Compass declination 20° East

Note:

I set guard post at corner with USFS 54-4 sign, placed USFS 54-3 and 54-4 signs on bearing tree and painted a red band at breast height on smoothed bark on bearing tree. Placed USFS 54-3 and 54-4 signs on reference mounds.

I hereby certify the above corner location was perpetuated as herein described on June 1, 1982.

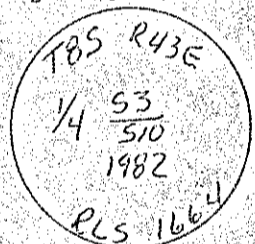

Terry Butler Terry Butler, Witness
Frank Vaughn Frank Vaughn, Witness

REGISTERED
PROFESSIONAL
LAND SURVEYOR

Carl E. Sundet
 OREGON
 JULY 14, 1978
 CARL E. SUNDET
 1664

Office of..... County of.....
 State of..... I hereby certify that the within instrument was filed in this office
 for record on the..... day of....., 19.....
 by
 (COUNTY OFFICIAL) (DEPUTY)

FILED JUNE 29, 1982
 BAKER COUNTY SURVEYOR
 SURVEY NO. 8-43-19