


CERTIFIED RECORD OF LAND CORNER MONUMENTATION

History of original corner establishment:

Corner originally established by W. Barr, under contract no. 372, dated 1880.

Marked basalt rock 18" x 10" x 8". Raised mound of rock.

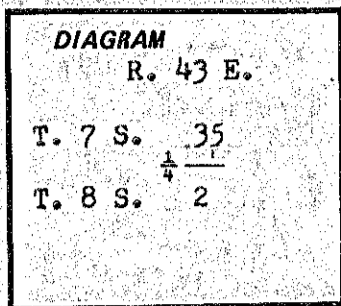

Description of corner evidence found:

Found no evidence of original corner.

Description of monument and accessories established to perpetuate the

original location of this corner: Set by proportionate measurement, a 2½" x 30" aluminum pipe with a ¾" aluminum cap 21" in ground in mound of stone. Cap marked;

Reference Mounds

- 3ft. x 3ft. mound of stone, N 13° E, 6.2 ft.
- 3ft. x 3ft. mound of stone, S 06° E, 7.3 ft.

T75 R43E  
 1/4 535  
 52  
 T85  
 1982  
 RLS 1664

Compass Declination 20° East

Note:

I set a guard post at the corner with USFS 54-4 sign and placed USFS 54-3 and 54-4 signs on reference mounds.

I hereby certify the above corner location was perpetuated as herein described on June 1, 1982.

Terry Butler Terry Butler, Witness

Frank Vaughn Frank Vaughn, Witness

REGISTERED  
 PROFESSIONAL  
 LAND SURVEYOR

Carl E. Sundet

OREGON  
 JULY 14, 1978  
 CARL E. SUNDET  
 1664

Office of..... County of.....  
 State of..... I hereby certify that the within instrument was filed in this office  
 for record on the..... day of....., 19....  
 ..... by .....  
 (COUNTY OFFICIAL) (DEPUTY)