


CERTIFIED RECORD OF LAND CORNER MONUMENTATION

History of original corner establishment:

Corner originally established by W. Barr, under contract no. 372, dated 1880.

Marked basalt rock 12" x 10" x 8". Raised mound of rock.

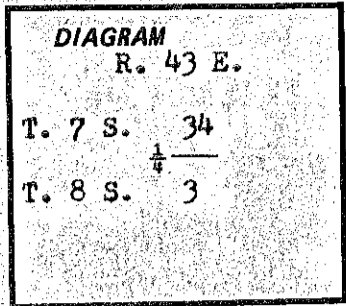

Description of corner evidence found:

Found 12" x 10" x 8" stone with 1/4 on north face, in a mound of stone.

We wire brushed scribing.

Description of monument and accessories I established to perpetuate the

original location of this corner: Set a 2 1/2" x 30" aluminum pipe with a 3 1/4" aluminum cap 24" in ground in mound of stone. Buried original stone alongside new monument. Cap marked;

Bearing Trees

13" ponderosa pine, N 69° W, 82.9 ft., scribed "1/4 S34" in upper blaze and "BT" and brass tag stamped RLS 1664 in lower blaze.

15" ponderosa pine, S 22° E, 118.8 ft., scribed "1/4 S3" in upper blaze and "BT" and brass tag stamped RLS 1664 in lower blaze.

T75 R43E  
 1/4 S34  
 1/4 S3  
 TBS  
 1982  
 RLS 1664

Compass declination 20° East

Note:

I set a guard post at corner with USFS 54-4 sign, and placed USFS 54-3 and 54-4 signs and painted a red band on smoothed bark at breast height on bearing trees.

I hereby certify the above corner location was perpetuated as herein described on June 3, 1982.

Terry Butler Terry Butler, Witness

Frank Vaughn Frank Vaughn, Witness

REGISTERED  
 PROFESSIONAL  
 LAND SURVEYOR

Carl E. Sundet  
 OREGON  
 JULY 14, 1978  
 CARL E. SUNDET  
 1664

Office of..... County of.....  
 State of..... I hereby certify that the within instrument was filed in this office  
 for record on the..... day of....., 19.....  
 ..... by .....  
 (COUNTY OFFICIAL) (DEPUTY)

FILED June 29, 1982  
 BAKER COUNTY SURVEYOR  
 SURVEY NO. 7-43-54  
8-43-21