


CERTIFIED RECORD OF LAND CORNER MONUMENTATION

History of original corner establishment:

Corner originally established by W. Barr, under contract no. 372, dated 1880.

Marked basalt rock 18" x 14" x 4". Raised mound of rock.

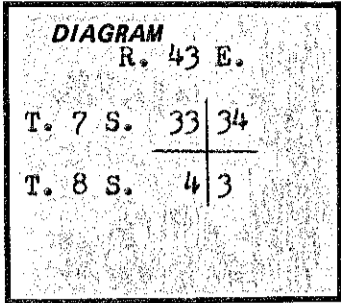

Description of corner evidence found:


Found no evidence of original stone.

Description of monument and accessories I established to perpetuate the

original location of this corner: Set a 2 1/2" x 30" aluminum pipe with a 3/4" aluminum cap, by proportionate measurement, 20" in ground in mound of stone. Cap marked;

Reference Mounds

- 3 1/2 ft. x 4 ft. mound of stone, N 25° W, 8.7 ft.
- 3 1/2 ft. x 3 1/2 ft. mound of stone, N 31° E, 7.4 ft.
- 3 1/2 ft. x 3 1/2 ft. mound of stone, S 34° W, 10.0 ft.
- 3 ft. x 3 ft. mound of stone, S 29° E, 9.5 ft.

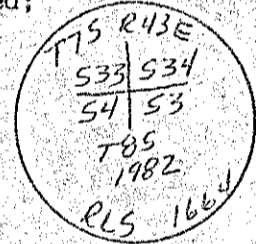

Compass declination 20° East

Note:

I set a guard post at corner with USFS 54-2 and 54-4 signs and placed USFS 54-3 and 54-4 signs in reference mounds.

I hereby certify the above corner location was perpetuated as herein described on June 3, 1982.

Terry Butler Terry Butler, Witness
Frank Vaughn Frank Vaughn, Witness

REGISTERED
 PROFESSIONAL
 LAND SURVEYOR

Carl E. Sundet
 OREGON
 JULY 14, 1978
 CARL E. SUNDET
 1664

Office of..... County of.....
 State of..... I hereby certify that the within instrument was filed in this office
 for record on the..... day of....., 19.....
 by

(COUNTY OFFICIAL)

(DEPUTY)