


CERTIFIED RECORD OF LAND CORNER MONUMENTATION

History of original corner establishment:

Corner originally established by W. Barr under contract No. 372, dated September 10, 1880. Set marked basalt rock 36"x20"x2" and raised mound of rock.

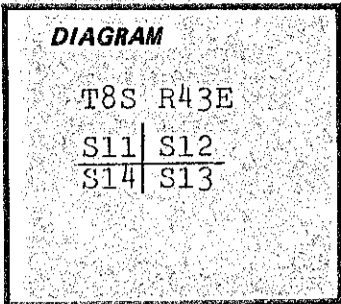


Description of corner evidence found:

Found 30"x20"x4" stone in north-south fence line. Stone marked 4 notches south and 1 notch east, stone lying down in mound of stone.

Description of monument and accessories established to perpetuate the original location of this corner:

Set 2 1/2" x 30" aluminum pipe with 3/4" aluminum cap 8" in ground in large mound of stone, marked: Placed original stone in base of mound alongside pipe.

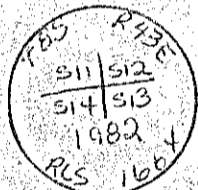

Accessories:

- 3'x3' mound of stone - N46°W - 8.7 ft.
- 3'x3' mound of stone - N25°E - 14.2 ft.
- 3'x2' mound of stone - S36°E - 8.4 ft.
- 4'x3' mound of stone - S39°W - 5.7 ft.

Compass declination 20° East

Note:

Placed 54-4 and BT tag in each mound of stone. Placed 54-4 sign to fence post 4' north

I hereby certify the above corner location was perpetuated as herein described in September 1982.

Frank Vaughn Frank Vaughn, Witness

REGISTERED PROFESSIONAL LAND SURVEYOR

Carl E. Sundet

OREGON
JULY 14, 1978
CARL E. SUNDET
1664

Office of..... County of.....
State of..... I hereby certify that the within instrument was filed in this office
for record on the..... day of....., 19.....
..... by

(COUNTY OFFICIAL)

(DEPUTY)