


CERTIFIED RECORD OF LAND CORNER MONUMENTATION

History of original corner establishment:

Corner originally established by Walden under contract # 198 dated July 1883  
Set basalt rock 16"x10"x9" 8" in-ground

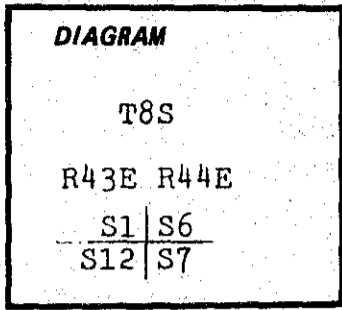


Description of corner evidence found:

Found 18"x12"x10" stone marked 1 notch north and 5 faint notches south

Description of monument and accessories | established to perpetuate the original location of this corner:

Set 2 1/2" x 30" aluminum pipe with 3/4" aluminum cap 26" in ground, in mound of stone, marked:  
Buried original stone alongside

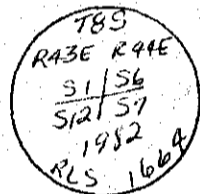

Accessories:

- 3' x 2' mound of stone - N58°W - 8.3 ft.
- 3' x 2' mound of stone - S57°W - 8.6 ft.

Compass declination 20° East

Note:

I set steel fence post 5' south of corner with USFS attention sign placed USFS bearing tree and attention signs in all mounds of stone.

I hereby certify the above corner was perpetuated as herein described in September 1982

REGISTERED PROFESSIONAL LAND SURVEYOR

*Carl E. Sunde*  
OREGON  
JULY 14, 1978  
CARL E. SUNDE  
166

Office of..... County of.....  
State of..... I hereby certify that the within instrument was filed in this office  
for record on the..... day of....., 19.....  
..... by .....  
(COUNTY OFFICIAL) (DEPUTY)

Form R6-7100-57 (9/71)

FILED Dec 20 1982  
BAKER COUNTY SURVEYOR  
SURVEY NO. 8-43-27  
8-44-33