


CERTIFIED RECORD OF LAND CORNER MONUMENTATION

History of original corner establishment:

Corner originally established by W. Barr, under contract no. 372, dated 1880.

Marked basalt rock 16" x 10" x 6". Raised mound of rock.

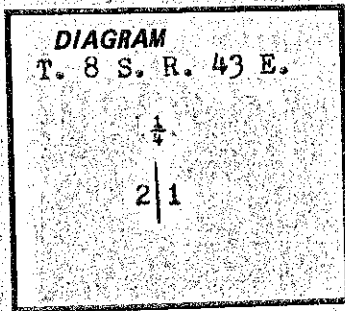

Description of corner evidence found:

None

Set by proportionate measurement

Description of monument and accessories established to perpetuate the original location of this corner:

Set 2½" x 30" aluminum pipe with 3¼" aluminum cap 26" in ground in mound of stone, marked:



Bearing trees:


- 11" ponderosa pine - N69°W - 31.1 ft. scribed "¼ S2" in upper blaze and "BT" and brass tag stamped RLS 1664 in lower blaze
- 22" douglas fir - N40°E - 15.3 ft. scribed "¼ S1" in upper blaze and "BT" and brass tag stamped RLS 1664 in lower blaze

Compass declination 20.34° East

Note:

I set steel fence post 5' north of corner location with USFS attention sign, placed USFS bearing tree signs on all bearing trees and painted red band at breast height on smoothed bark on all bearing trees.

I hereby certify the above corner was perpetuated as herein described in November 1982

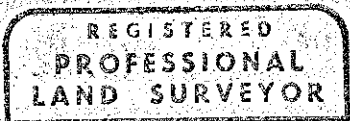

Office of..... County of.....
 State of..... I hereby certify that the within instrument was filed in this office
 for record on the..... day of....., 19.....
 by
 (COUNTY OFFICIAL) (DEPUTY)

