


CERTIFIED RECORD OF LAND CORNER MONUMENTATION

History of original corner establishment:

Corner originally established by W. Barr, under contract no. 372, dated 1880.

Marked basalt rock 14" x 10" x 8". Raised mound of rock.

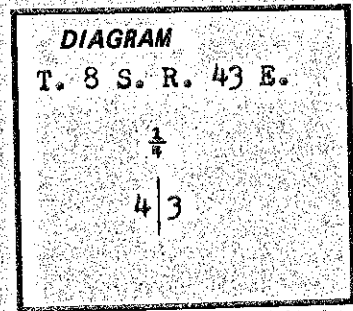


Description of corner evidence found:

None

Set by proportionate measurement

Description of monument and accessories established to perpetuate the original location of this corner:

Set 2 1/2" x 30" aluminum pipe with 3 1/4" aluminum cap 22" in ground in mound of stone, marked:

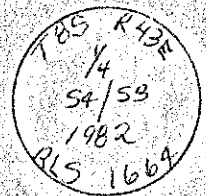

Accessories:

- 3' x 1 1/2' mound of stone - S19°W - 11.6 ft.
- 3' x 1 1/2' mound of stone - S51°E - 11.3 ft.

Compass declination 20.75° East

Note:

I set steel fence post 5' north of corner with USFS attention sign and placed USFS bearing tree signs and attention signs on all accessories.

I hereby certify the above corner was perpetuated as herein described in November 1982



Office of..... County of.....
 State of....., I hereby certify that the within instrument was filed in this office
 for record on the..... day of....., 19.....
 by.....
 (COUNTY OFFICIAL) (DEPUTY)

FILED Dec 20 1982
 BAKER COUNTY SURVEYOR
 SURVEY NO. 8-43-29