


CERTIFIED RECORD OF LAND CORNER MONUMENTATION

History of original corner establishment:

Corner originally established by Barr under contract #372 dated 1880, set marked basalt rock 15"x10"x6"

Corner remonumented by James Hanley, county surveyor in 1980, set 2 1/2" brass cap on 1" pipe and referenced:

- a 21" pine bears N48°E - 153.2 ft. mkd. T8SR43ES3BT
- a 15" pine bears S02°E - 148.7 ft. mkd. T8SR43ES10BT
- a 14" pine bears S26°W - 95.3 ft. mkd. T8SR43ES9BT
- a 22" pine bears N01°W - 381.1 ft. mkd. T8SR43ES4BT

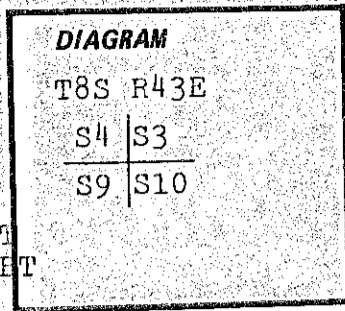

Description of corner evidence found:

Found County Surveyor brass cap 1980 marked:  
Bearing trees:

- 22" ponderosa pine - N01°W - 381.66 ft.
- 22" ponderosa pine - N51°E - 153.33 ft. scribed 8SR43 S3  
in pitchy open blaze
- 16" ponderosa pine - S84°E - 148.82 ft. scribed 8SR43 S10  
in pitchy open blaze
- 15" ponderosa pine - S34°W - 95.20 ft. scribed 8SR43 in  
pitchy open blaze.



Compass declination 20 3/4° East

Description of monument and accessories I established to perpetuate the original location of this corner:

Note:

I placed USFS bearing tree and attention signs on all bearing trees and painted red band on smoothed bark at breast height on all bearing trees. I set steel fence post 5' from corner with USFS 54-4 sign. I hereby certify the above corner was perpetuated as herein described in November 1982.

REGISTERED  
PROFESSIONAL  
LAND SURVEYOR

*Carl E. Sundet*

OREGON  
JULY 14, 1978  
CARL E. SUNDET  
1864

Office of..... County of.....  
State of..... I hereby certify that the within instrument was filed in this office  
for record on the..... day of....., 19.....  
..... by .....  
(COUNTY OFFICIAL) (DEPUTY)

FILED July 25 1983  
BAKER COUNTY SURVEYOR  
SURVEY NO. 8-43-36