


CERTIFIED RECORD OF LAND CORNER MONUMENTATION

History of original corner establishment:

Corner originally established by Walden under contract #198 dated July 1873

Set 30" x 12" x 18" sandstone 8" in ground

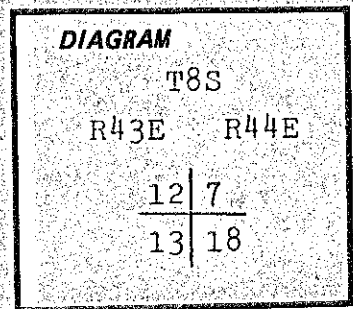


Description of corner evidence found:

Found 18" x 14" x 6" stone with 6 notches north and 4 notches south firmly set in ground

Description of monument and accessories established to perpetuate the original location of this corner:

Set 2 1/2" x 30" aluminum pipe with 3/4" aluminum cap 24" in ground in mound of stone, marked:
Buried original stone alongside.

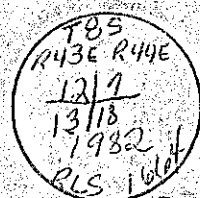

Bearing trees:

- 17" ponderosa pine - N53 1/2° W - 51.2 ft. scribed "T8SR43E S12" in upper blaze and "BT" and brass tag stamped RLS 1664 in lower blaze
- 16" ponderosa pine - N57° E - 34.5 ft. scribed "T8SR44E S7" in upper blaze and "BT" and brass tag stamped RLS 1664 in lower blaze
- 20" ponderosa pine - S24 1/2° E - 154.2 ft. scribed "T8SR44E S18" in upper blaze and "BT" and brass tag stamped RLS 1664 in lower blaze
- 20" ponderosa pine - S60° W - 116.0 ft. scribed "T8SR43E S13" in upper blaze and "BT" and brass tag stamped RLS 1664 in lower blaze

Compass declination 20 3/4° East

Note:

I set steel fence post 4' south of corner with USFS 54-4 sign, placed USFS bearing tree and attention signs on all bearing trees and painted red band on smoothed bark at breast hieght on all bearing trees.

I hereby certify the above corner was perpetuated as herein described in November 1982.

Witness: Frank Vaughn
Roger Walters



Office of..... County of.....
State of..... I hereby certify that the within instrument was filed in this office
for record on the..... day of....., 19.....

Carl E. Sundet

..... by

(COUNTY OFFICIAL)

(DEPUTY)



FILED July 25 1983
 BAKER COUNTY SURVEYOR
 SURVEY NO. 8-43-39
8-44-57