


CERTIFIED RECORD OF LAND CORNER MONUMENTATION

History of original corner establishment:

Corner originally established by Walden under contract #198 dated July 1873

Set quartz stone 14' x 8" x 6" 8" in ground

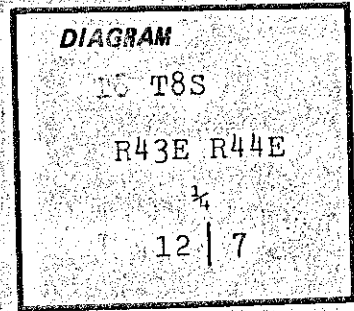


Description of corner evidence found:

No evidence of original stone.  
Set by single proportionate measurement

Found 1/2" iron pipe N19 1/2° E - 82.1 ft.

Description of monument and accessories established to perpetuate the original location of this corner:

Set 2 1/2" x 30" aluminum pipe with 3/4" aluminum cap 26" in ground in mound of stone, marked:

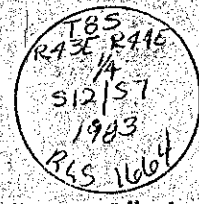

Bearing trees:

18" ponderosa pine - S04 1/2° W - 151.9 ft. scribed "1/4 S12" in upper blaze and "BT" and brass tag stamped RLS 1664 in lower blaze  
25" ponderosa pine - S32° E - 166.8 ft. scribed "1/4 S7" in upper blaze and "BT" and brass tag stamped RLS 1664 in lower blaze

Compass declination 19 3/4° East

Note:

I set steel fence post 6' north of corner with USFS 54-4 sign, placed USFS bearing tree and attention signs on all bearing trees and painted red band at breast height on smoothed bark on all bearing trees.

I hereby certify the above corner was perpetuated as herein described in June 1983

Witness: Ron Horton



Office of..... County of.....  
State of....., I hereby certify that the within instrument was filed in this office  
for record on the..... day of....., 19....  
..... by  
(COUNTY OFFICIAL) (DEPUTY)