



SITUATED IN THE E1/2 OF THE NE1/4 OF SECTION 33
AND THE N1/2 OF THE NW1/4 OF SECTION 34
IN T.8 S., R.43 E., W.M.

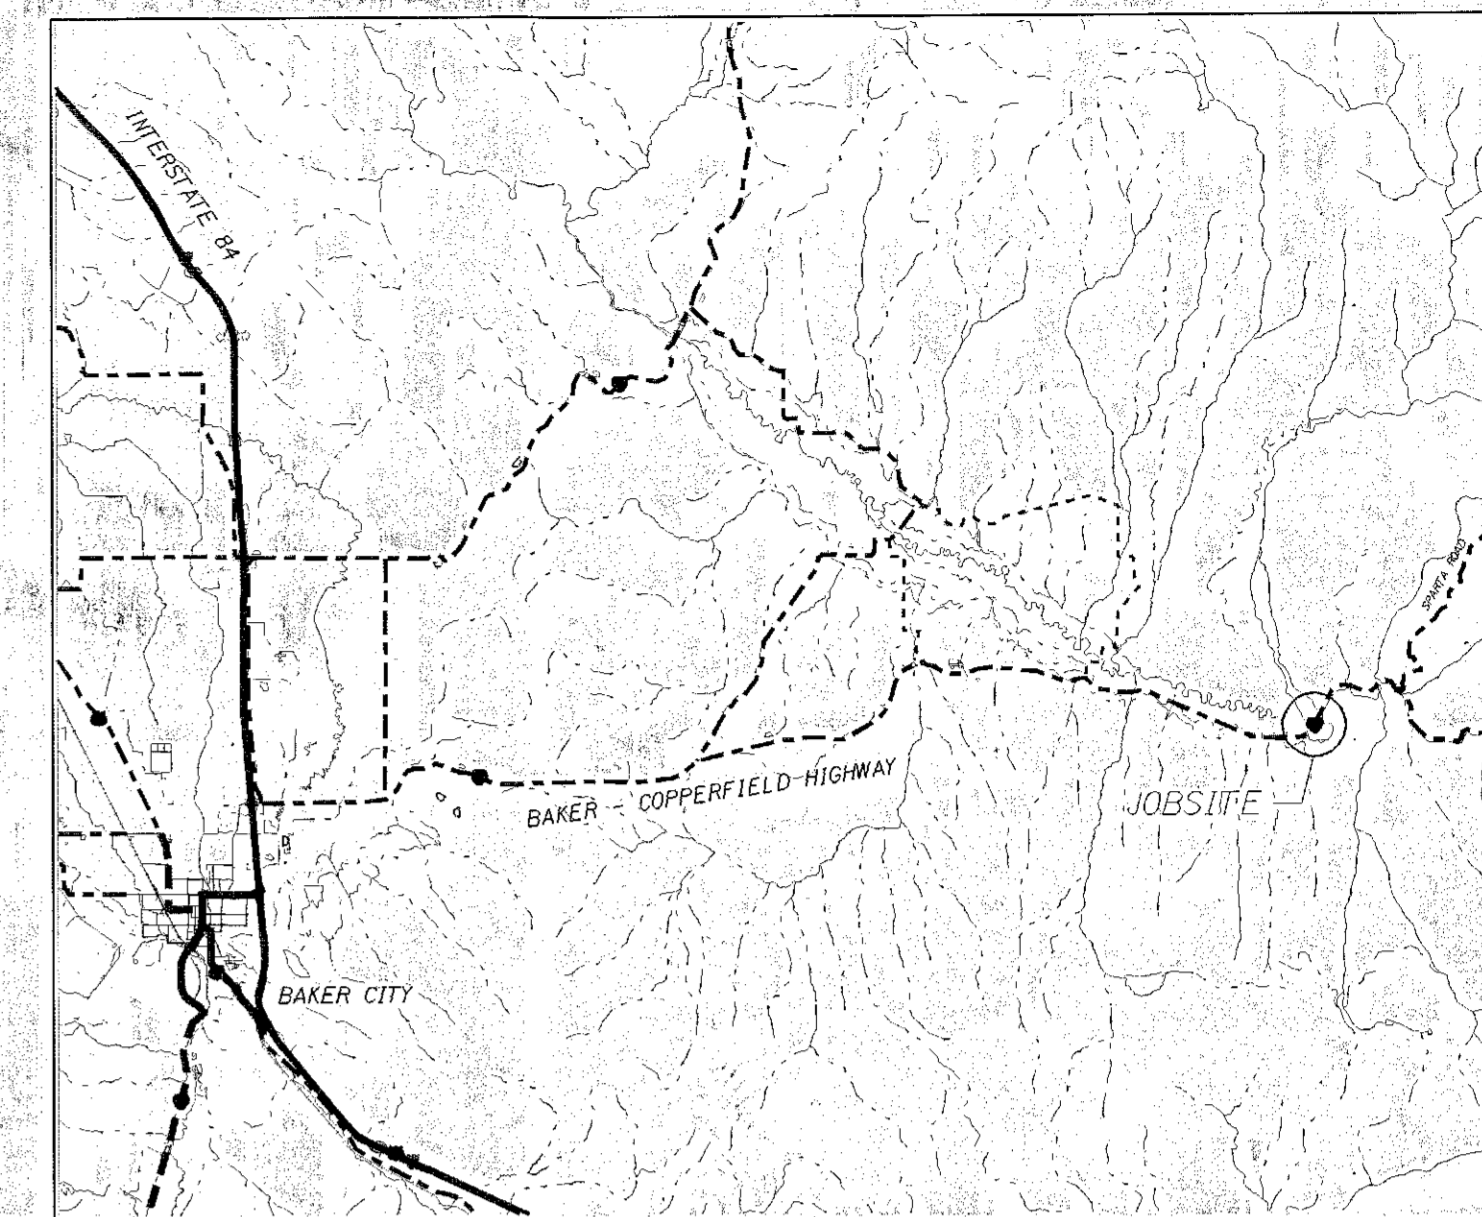

COORDINATE TABLE			
CENTERLINE STATION	OFFSET(m)	NORTHING	EASTING
34+943.257 PT	12.192 LT.	9703.397	39859.033
35+088.067 PS	12.192 LT.	9648.382	39992.954
35+088.067 PS	12.192 RT.	9625.698	39983.664
35+209.987 PSC	12.192 LT.	9613.768	40105.860
35+209.987 PSC	12.192 RT.	9589.531	40103.185
35+300.000 POC	25.000 LT.	9634.149	40186.023
35+310.000 POC	12.192 RT.	9602.031	40207.121
35+310.000 POC	18.000 RT.	9596.572	40209.106
35+382.770 PCS	31.000 LT.	9673.262	40246.439
35+382.770 PCS	28.000 RT.	9627.465	40283.637
35+478.752 POS	21.336 RT.	9708.274	40346.865
35+504.690 PT	12.192 LT.	9748.917	40334.481
35+504.690 PT	21.336 RT.	9729.727	40361.974

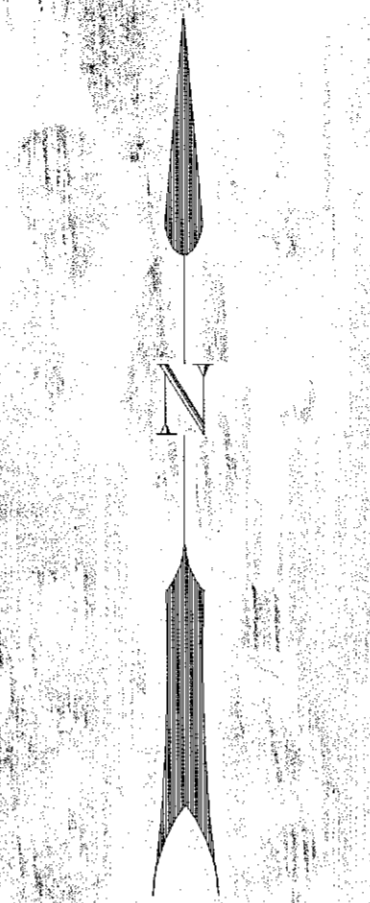

Fd. Section Corner
Brass Cap on 1" Iron Pipe
Stamped:
T8S R43E
29 28
32 33
CS 1978"
N. 9 999.522
E. 38 393.712

29 | 28
32 | 33

SURVEY NARRATIVE

THE PURPOSE OF THIS SURVEY WAS TO DESCRIBE AND MONUMENT LAND ACQUIRED BY THE OREGON DEPARTMENT OF TRANSPORTATION FOR RIGHT-OF-WAY PURPOSES ON THE BAKER-COPPERFIELD HIGHWAY ROCKFALL PROJECT. PROPERTY LINE ADJUSTMENT OF SAID SURVEY BEGINS AT ENGINEERS METRIC STATION 35+209.987 PSC TO STATION 35+504.690 PT, LEFT OF CENTERLINE, AND STATION 35+310.000 POC TO STATION 35+478.752 POS, RIGHT OF CENTERLINE, SAID PROPERTY BEING LOCATED IN THE E1/2 OF THE NE1/4 OF SECTION 33 AND THE N1/2 OF THE NW1/4 OF SECTION 34, IN T.8 S., R.43 E., W.M., OF BAKER COUNTY, OREGON.

THE BASIS OF BEARING FOR THIS SURVEY WAS ESTABLISHED FROM FOUND HIGHWAY MONUMENTATION MARKING ENGINEERS STATION 1146+43.2 PT, AT 40.00 FEET LEFT OF CENTERLINE, AND STATION 1151+18.3 PS, AT 40.00 FEET LEFT OF CENTERLINE. OREGON DEPARTMENT OF TRANSPORTATION RIGHT-OF-WAY DRAWING NO. 6B-16-10, DATED 1945, INDICATES A BEARING OF S 67°40'00" E BETWEEN SAID HIGHWAY STATIONS. ADDITIONAL HIGHWAY MONUMENTATION WAS FOUND WHICH COINCIDES WITH SAID ODOT DRAWING. THESE MONUMENTS ALSO AGREE WITH WARRANTY DEED LOCATED IN VOLUME 81-16 ON PAGE 038 IN THE BAKER COUNTY COURTHOUSE.

LEGEND

- FOUND HIGHWAY RW MONUMENT, NAIL SET IN CONCRETE
- SET 5/8" IRON PIN WITH ALUMINUM CAP
- () DISTANCE IN ENGLISH UNIT
- [] FIELD MEASURED
- LC LONG CHORD
- SC SHORT CHORD
- C.L. CENTERLINE

REFERENCES

- ODOT DRAWING 6B-16-10
- BAKER COUNTY SURVEY NO. 8-43-1
- DEED IN VOL. 81-16, PAGE 038, BAKER COUNTY
- ODOT DRAWING 10B-9-5
- ODOT FILE 6499001

REGISTERED
PROFESSIONAL
LAND SURVEYOR
Robert E. Butler
OREGON
JULY 25, 1995
ROBERT E. BUTLER
2719

EXPIRES 12/31/97
OREGON DEPARTMENT OF TRANSPORTATION
3012 ISLAND AVE
LAGRANDE, OR 97850

SURVEY FOR OREGON DEPARTMENT OF TRANSPORTATION	
PROJECT: BAKER - COPPERFIELD HIGHWAY ROCKFALL	
SURVEYED BY: ROBERT E. BUTLER	DRAFTED BY: CURTIS B. STOCKHOFF
DATE SURVEYED: 6-4-96 TO 7-9-96	SHEET 1 OF 1

FILED 8-15-96
BAKER COUNTY SURVEYOR
SURVEY NO. 8-43-412