

CERTIFIED RECORD OF LAND CORNER MONUMENTATION


V-9
T 8 S, R 43 E

History of original corner establishment:

Corner originally established by W.B. Barr under contract dated September 10, 1880.

Surveyor General Record states:
Marked basalt rock 16"x14"x8" for corner to Sections 28,29,32,33, and raised mound of stone alongside.

Baker Co. Survey No. 8-43-1 indicates finding a 14"x8"x6" quartz stone in rock mound and remonumented with a 2 1/2" Brass Cap on a 1" I.P. and buried stone 5' south.

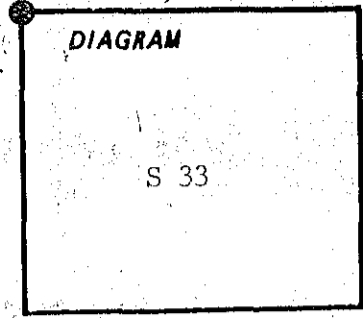

Description of corner evidence found:

Found Brass Cap as per Baker Co. Survey No. 8-43-1, performed by James Hanley in April/May of 1978, as shown below.

No reference monuments found.

Description of monument and accessories I established to perpetuate the original location of this corner:

From found 2 1/2" Brass Cap monument, I set reference monuments as follows:


- A 5/8"x30" iron pin with aluminum cap which bears S 16° E, 15.79 feet, marked SE RP.
- A 5/8"x30" iron pin with aluminum cap which bears N 16° E, 16.21 feet, marked NE RP.
- A 5/8"x30" iron pin with aluminum cap which bears N 40° W, 16.15 feet, marked NW RP.
- A 5/8"x30" iron pin with aluminum cap which bears S 33° W, 20.59 feet, marked SW RP.

EXPIRES 12/31/97
ORE. DEPT. OF
TRANS.
3012 ISLAND AVE.
LA GRANDE, OR
97850

REGISTERED
PROFESSIONAL
LAND SURVEYOR

Robert E. Butler

OREGON
JULY 25, 1995
ROBERT E. BUTLER
2733

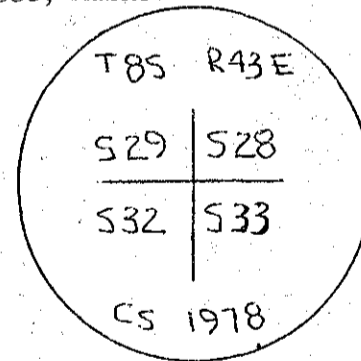

I used a steel tape and magnetic compass in the establishment of the accessories. I used a declination of 20° East.

Office of..... County of.....
State of....., I hereby certify that the within instrument was filed in this office
for record on the..... day of....., 19.....
..... by

(COUNTY OFFICIAL)

(DEPUTY)

Form R6-7100-57 (9/71)

FILED SEPT. 11, 1996
BAKER COUNTY SURVEYOR
SURVEY NO. 8-43-43

*GPO-591 971, 1988