


P-9160-2  
Nov. 1964  
(formerly AI-10)

UNITED STATES  
DEPARTMENT OF THE INTERIOR  
BUREAU OF LAND MANAGEMENT  
TOWNSHIP DIAGRAM  
SCALE: 1 INCH = 1 MILE

TOWNSHIP 8 South, RANGE 14 East, Willamette MER.  
STATE Oregon

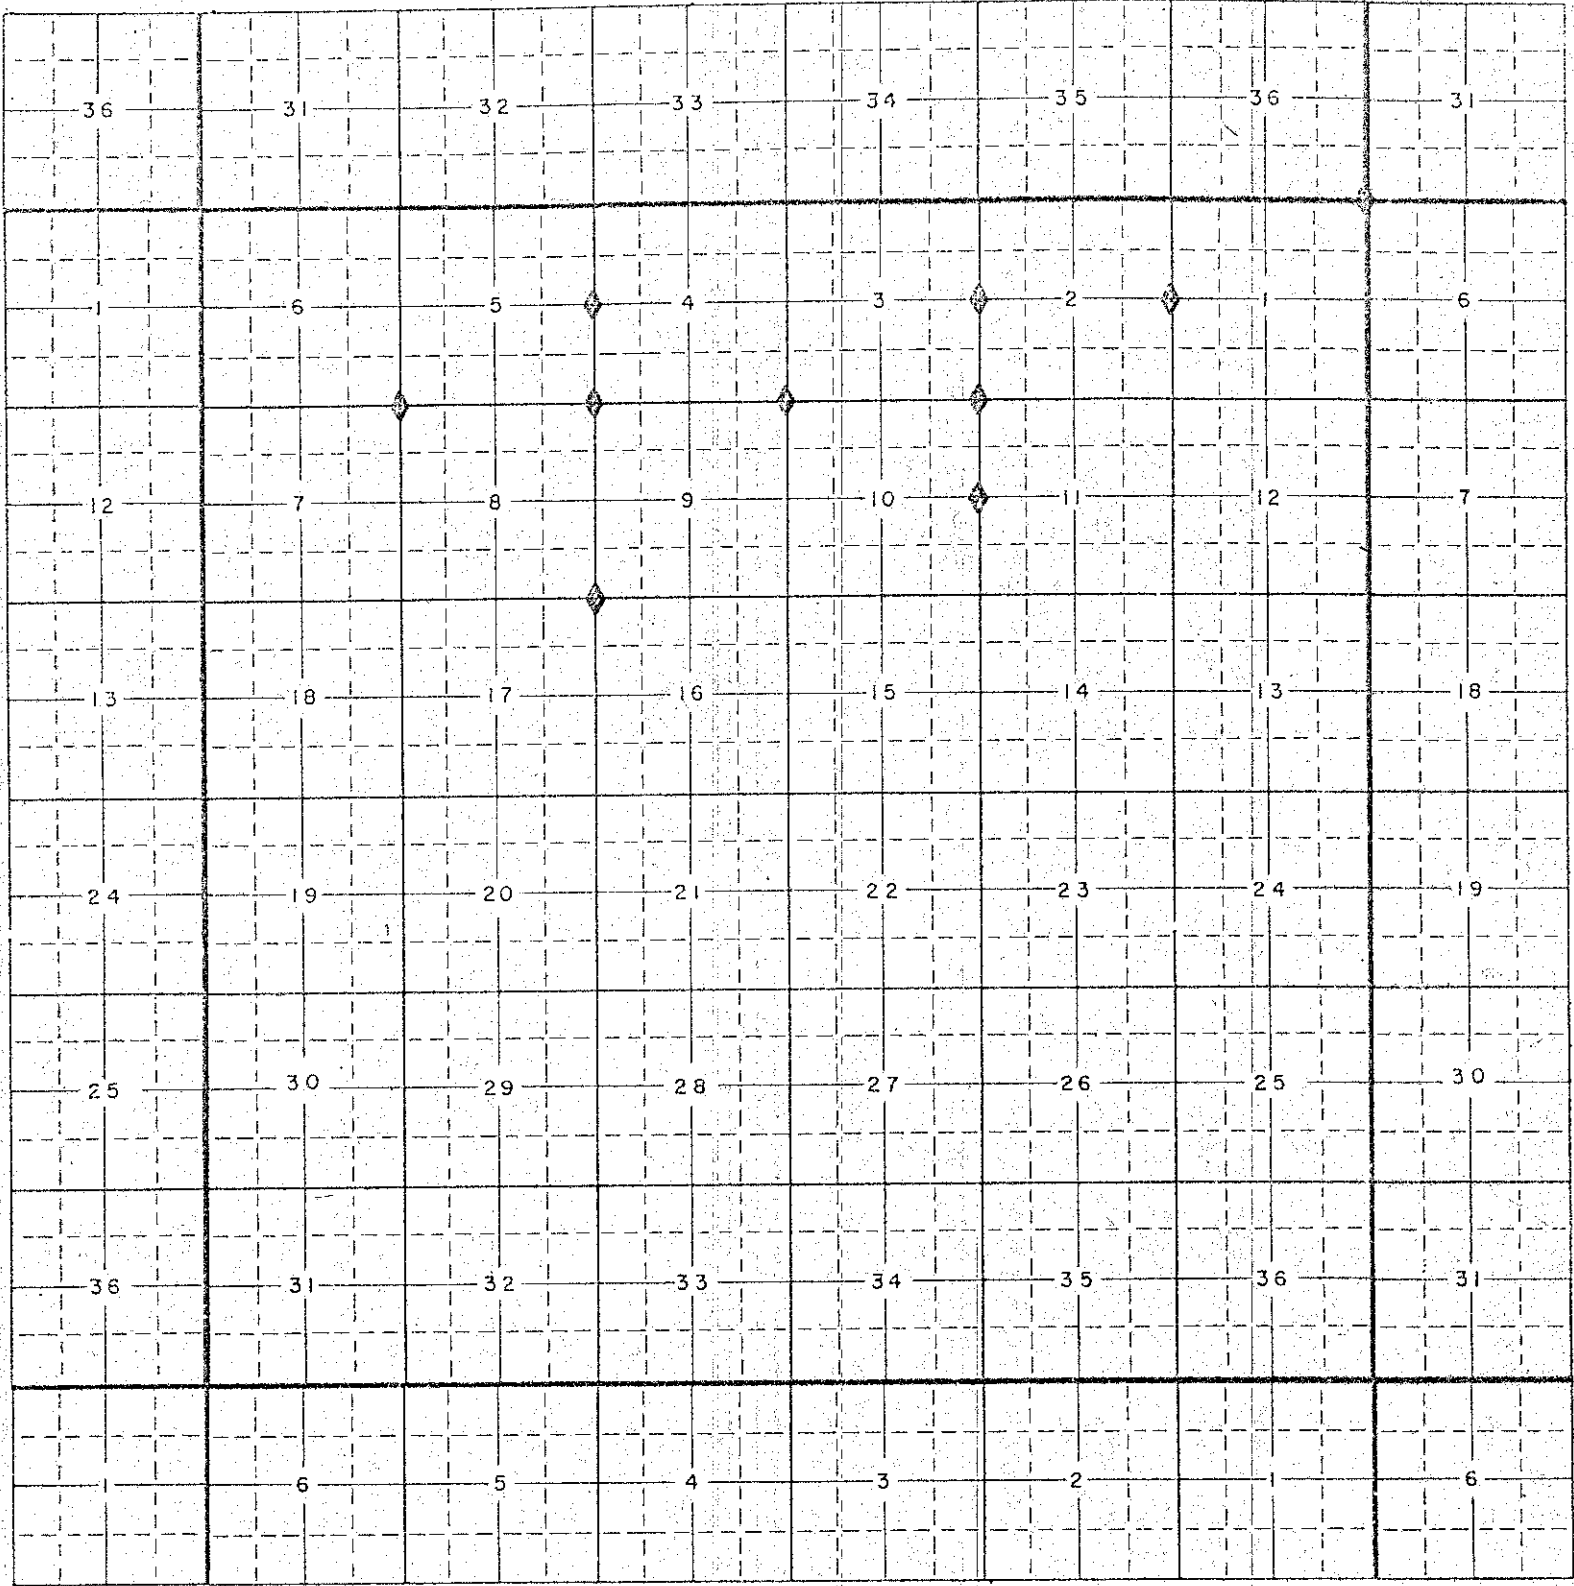

Baker County  
Baker District  
Wallowa-Whitman National Forest, Region 6

◆ Corners Remonumented

FILED Nov. 18, 1974  
BAKER COUNTY SURVEYOR  
SURVEY NO. 8-44-1