


Center of section  
 16 | 16  
 16 | 16  
 N 09° 37' 26" E  
 BRASS BASE BEARING  
 CAP  
 1/4 COR.  
 16 | 15  
 BRASS CAP

BRASS CAPS SET BY COUNTY

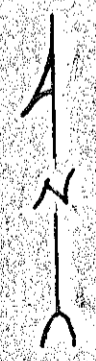

BAKER COUNTY ROAD NO. 852

OF ROAD ESTABLISHED BY SPLITTING EXISTING ROADWAY

N/L OF PROPERTY FOLLOWS EXISTING FENCE LINE

EXISTING FENCE

5.24 ACRES

FILED April 29, 1977  
 BAKER COUNTY SURVEYOR  
 SURVEY NO. 8-44-3

SURVEY FOR  
 JOHN STANSBERRY

REGISTERED PROFESSIONAL LAND SURVEYOR  
*Paul J. Ferguson*  
 OREGON  
 MAY 7, 1943  
 PAUL J. FERGUSON  
 254

MONUMENTS SET	o	Surveyed By	W. THEISS	Drwn. By	W. D. T.	Date	4-15-77	SCALE	1" = 100'
MONUMENTS FOUND	•	Date	3-5-77	Checked By				File No.	
BAKER COUNTY OREGON		SECTION	15	T&S	R44W	WM.			DLC