


CERTIFIED RECORD OF LAND CORNER MONUMENTATION

History of original corner establishment:

Corner established by Barin and Walden under GLO contract no. 198 dated July 15, 1873.

Surveyor's General records state:

Set basalt rock 14 x 8 x 6 ins, 8 ins in the ground for cor to Secs. 24, 19, 13, 18.

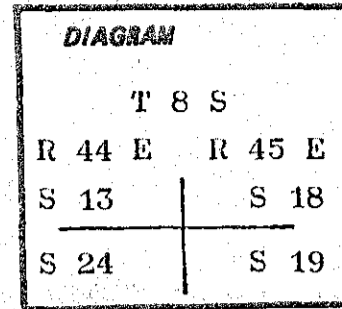


Description of corner evidence found:

Found a basalt stone (broken on one end) at northwest edge of rock jack from which the fence runs north, south and west. Identified 3 notches on south and 6 notches on west sides.

Description of monument and accessories established to perpetuate the original location of this corner:

Set a 2½ inch brass cap on a 1 inch iron pipe, 31 inches long and projecting 8 inches out of the ground with a surrounding rock mound. Buried original stone alongside and north of brass cap.

Brass cap marked thus:

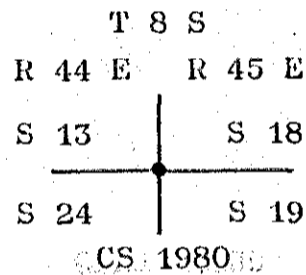

I hereby certify that the above described corner monument was correctly re-established under my direct supervision on Sept. 24, 1980, and witnessed by Bill Hanley and Jim DeMastus.

REGISTERED  
PROFESSIONAL  
LAND SURVEYOR

*James D. Hanley*

OREGON  
SEPTEMBER 23, 1977  
JAMES D. HANLEY  
1206

Office of..... County of.....  
State of....., I hereby certify that the within instrument was filed in this office  
for record on the..... day of....., 19.....  
..... by .....  
(COUNTY OFFICIAL) (DEPUTY)

Form R6-7100-51 (9/71)

FILED Oct. 16, 1980  
BAKER COUNTY SURVEYOR  
SURVEY NO. 8-44-7

★ GPO-798-276