


CERTIFIED RECORD OF LAND CORNER MONUMENTATION

History of original corner establishment:

Corner established by W. B. Barr under GLO contract no. 388, Dated May 7, 1881.

Surveyor's General records state:

Marked basalt rock 12 x 9 x 6 ins for 1/4 sec. corner. Raised mound of rock as per instructions.

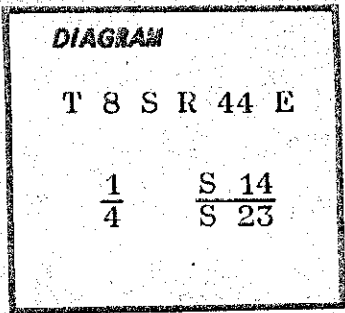

Description of corner evidence found:

Found basalt stone of proper dimensions in ancient downed fence line which runs in an east and west direction.

Description of monument and accessories I established to perpetuate the original location of this corner:

Set a 2½ inch brass cap on a 1 inch iron pipe, 31 inches long and projecting 4 inches above the ground. Buried stone alongside and north of brass cap.

Brass cap marked thus: T 8 S R 44 E

$\frac{1}{4}$  •  $\frac{S 14}{S 23}$

CS 1980

I hereby certify that the above described corner monument was properly re-established by Bill Hanley (ORLS 1639) under my supervision on Sept. 24, 1980, and witnessed by Jim DeMastus.

REGISTERED  
PROFESSIONAL  
LAND SURVEYOR

*James D. Hanley*  
OREGON  
SEPTEMBER 23, 1977  
JAMES D. HANLEY  
1206

Office of..... County of.....  
State of..... I hereby certify that the within instrument was filed in this office  
for record on the..... day of....., 19.....

..... by .....  
(COUNTY OFFICIAL) (DEPUTY)

Form R6-7100-57 (9/71)

FILED Oct 16 1980  
BAKER COUNTY SURVEYOR  
SURVEY NO. 8-44-9