


CERTIFIED RECORD OF LAND CORNER MONUMENTATION

History of original corner establishment:

Corner established by W. B. Barr under GLO contract no. 388 dated May 7, 1881.

Surveyor General records state:

Marked basalt rock 10 x 10 x 5 ins for 1/4 sec cor and raised mound of stone as per instructions.

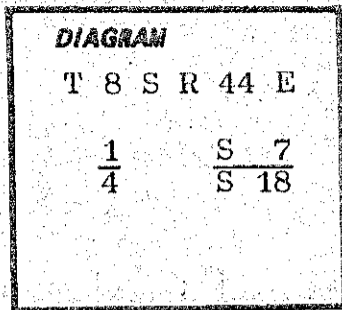

Description of corner evidence found:

Found a stone 16 x 10 x 5 ins marked 1/4 on north face in small rock mound .

The ancient remains of an old fence line run north and south from the found stone.

Description of monument and accessories | established to perpetuate the original location of this corner:

Set a 2½ inch brass cap on a 1 inch iron pipe 31 inches long and projecting 6 inches out of the ground with a surrounding rock mound. Buried original stone alongside.


Brass cap marked thus;

T 8 S R 44 E

$\frac{1}{4}$        $\frac{S}{S}$        $\frac{7}{18}$

CS 1981

I hereby certify that the above described corner was properly remonumented an Jan. 29, 1981, and witnessed by Jim DeMastus and Bill Hanley.

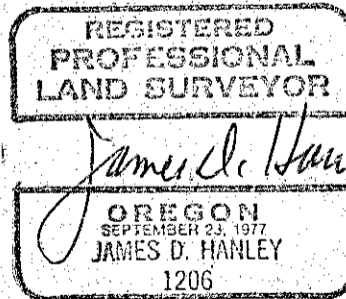

Office of..... County of.....  
State of....., I hereby certify that the within instrument was filed in this office  
for record on the..... day of....., 19.....

..... by .....  
(COUNTY OFFICIAL) (DEPUTY)