

CERTIFIED RECORD OF LAND CORNER MONUMENTATION


1756

History of original corner establishment:

This corner originally established by W.B. Barr under contract dated 1881.
Set 16 X 14 X 6 in. stone for 1/4 sec. corner.
Raised mound of rock as per instructions.

In August 1974 a remonumentation of original corners was done by the B.L.M. : They set a 2 1/2" X 28" brass capped steel pipe 20" in the ground in a mound of stone from which

- A Ponderosa Pine, 22 in. diam. bears N24° E 93 lks. dist., mkd. 1/2 S11 BT
- A Twin Ponderosa Pine, 21 in. diam. bears N2° E 163 lks. dist., mkd. 1/4 S10 BT

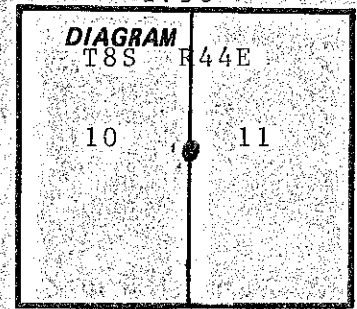

Description of corner evidence found:

At the corner I found the brass cap as set by the B.L.M. in 1974.
A 24" Ponderosa Pine bears N24° E 61.4 ft. mkd. 1/2 S11 BT
The Twin Ponderosa Pine as set by the B.L.M. has blown down.

Brass cap stamped as shown:

T8S R 44E
1/4
S10 | S11
1974

Description of monument and accessories I established to perpetuate the original location of this corner:

To replace the Twin Ponderosa Pine set by the B.L.M.

A 12" Ponderosa Pine bears N6° W 171.44 ft.
mkd. 1/4 S10 BT Nail in E base.

Bearing taken with a staff compass
declination 18 1/2° East per 1980 Isogonic chart

Distances are pulled to a 60d nail with brass washer stamped L.S. 1898 driven in the side center of bearing trees.

17- June 1982

REGISTERED
PROFESSIONAL
LAND SURVEYOR

Harry C. Hildebrand

OREGON
JULY 12, 1980
HARRY C. HILDEBRAND
1898

Office of..... County of.....
State of..... I hereby certify that the within instrument was filed in this office
for record on the..... day of....., 19.....
..... by

(COUNTY OFFICIAL) (DEPUTY)

FILED June 22, 1982
BAKER COUNTY SURVEYOR
SURVEY NO. 8-44-13