


CERTIFIED RECORD OF LAND CORNER MONUMENTATION

History of original corner establishment:

The original survey was done by Chet M. Foster
Dep. Surveyor in June 1872

COR 2 is a post marked W.H.T./2

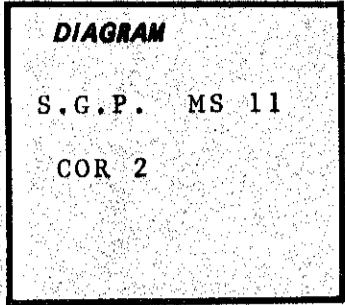

Description of corner evidence found:

At the corner I found a 4" x 6" X 24" wooden post
marked COR lying on the ground next to a 5/8" X 30"
plastic capped rebar by William Hanley under Survey NO. 8-44-10.


Description of monument and accessories I established to perpetuate the
original location of this corner:

I replaced William Hanley's rebar with a
2 1/2" X 32" brass capped steel pipe 24" in the
ground in a mound of stone, from which

A 6" White fir bears S13° 15' E 16.21 ft.
marked COR 2/ MS 11 BT Nail in E. base.

A 12" White fir bears S52° W 12.18 ft.
marked COR 2/ MS 11 BT Nail in S. base.

Monument stamped
S.G.P. MS. 11

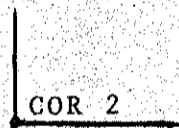

Bearings taken with a staff compass declination
18 1/2 East per 1980 Isogonic chart.

1982
O.R.L.S. 1898

Distances pulled to 60d nails with brass washers
stamped L.S.1898 driven in the side center of
bearing trees.

17-June 1982
REGISTERED
PROFESSIONAL
LAND SURVEYOR
Harry C. Hildebrand
OREGON
JULY 18, 1900
HARRY C. HILDEBRAND
1898

Office of..... County of Baker
State of Oregon....., I hereby certify that the within instrument was filed in this office
for record on the..... day of....., 19.....
..... by

(COUNTY OFFICIAL)

(DEPUTY)