


CERTIFIED RECORD OF LAND CORNER MONUMENTATION

History of original corner establishment:

The original survey was done by Chet M. Foster  
Dep. Surveyor, in June 1872.  
Cor 3 is a post marked W.H.T. 3

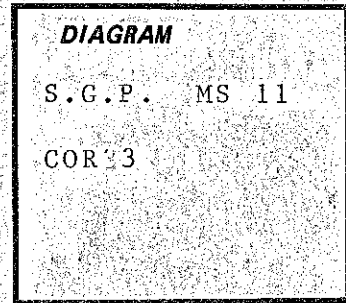

Description of corner evidence found:

At the corner I found a 4" X 6" X 42" wooden post marked COR NO 3  
12" in the ground with a 5/8" X 30" plastic capped rebar driven  
through the base. Set by William Hanley under Survey NO 8-44-10.

Description of monument and accessories I established to perpetuate the  
original location of this corner:

I replaced William Hanley's rebar with a 2 1/2" X 32"  
brass capped steel pipe 28" in the ground from which

A 10" White Fir bears S22° 15' E 14.24 ft.  
marked COR 3/ MS 11 BT Nail in E. base.

S.G.P. MS 11

A 10" White Fir bears N72° 15' W 14.97 ft.  
marked COR 3/ MS 11 BT Nail in S. base.

COR 3


1982

Bearings taken with a staff compass declination  
18 1/2° East per 1980 Isogonic chart.

O.R.L.S. 1898

Distances pulled to 60d nails with brass washers  
stamped L.S. 1898 driven in the side center of  
bearing trees.

17-June 1982

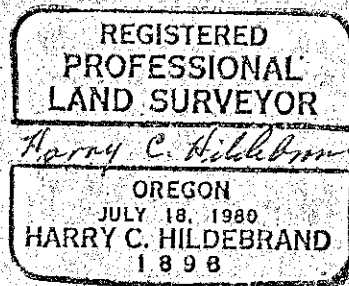

Office of..... County of.....

State of....., I hereby certify that the within instrument was filed in this office  
for record on the..... day of....., 19.....

..... by.....  
(COUNTY OFFICIAL) (DEPUTY)