


CERTIFIED RECORD OF LAND CORNER MONUMENTATION

History of original corner establishment:

The original survey was done by Chet M. Foster  
Dep. Surveyor, in June 1872

Cor 6 is a post marked W H P 6

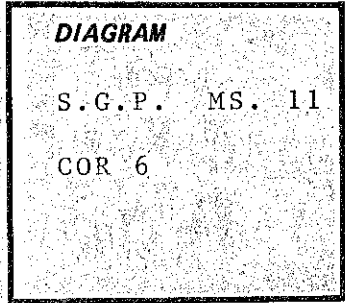

Description of corner evidence found:

At the corner I found a 5/8" X 30" plastic capped rebar set by  
William Hanley under Survey No. 8-44-10.

Description of monument and accessories I established to perpetuate the  
original location of this corner:

I replaced William Hanley's rebar with a 2 1/2" X 32"  
brass capped steel pipe 22" in the ground from which

An 8" White Fir bears S58°45'E 31.37 ft.  
Marked COR 6/MS11 BT Nail in W. base.

An 8" Ponderosa Pine bears S52°30'W 23.21 ft.  
Marked COR 6/MS11 BT Nail in N. base.


Monument stamped:

S.G.P. MS.11

Bearings taken with a staff compass declination  
18 1/2° East per 1980 Isogonic chart.

Distances pulled to 60d nails with brass washers  
stamped L.S.1898 driven in the side center of  
the bearing trees.

COR 6

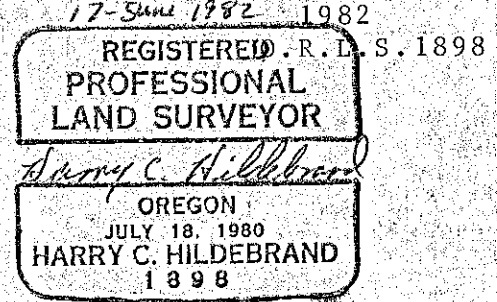

Office of..... County of.....

State of....., I hereby certify that the within instrument was filed in this office  
for record on the..... day of....., 19.....

..... by .....

(COUNTY OFFICIAL)

(DEPUTY)

Form R6-7100-57 (9/71)

FILED June 22, 1982  
BAKER COUNTY SURVEYOR  
SURVEY NO. 8-44-20