


CERTIFIED RECORD OF LAND CORNER MONUMENTATION

History of original corner establishment:

The original survey was done by Chet M. Foster
Dep. Surveyor, in June 1872.

Cor 5 is a post marked W H P 5

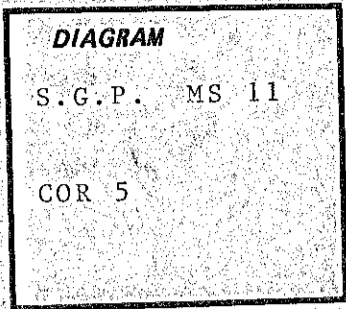

Description of corner evidence found:

At the corner I found a 5/8" X 30" plastic capped rebar set for the corner
by William Hanley under survey No. 8-44-10.

Description of monument and accessories I established to perpetuate the
original location of this corner:

I replaced William Hanley's rebar with a 2 1/2" X 32"
brass capped steel pipe 27" in the ground, from which

A 13" ponderosa Pine bears N71°E 16.51 ft
Marked COR 5/MS 11 BT Nail in N. base

A 10" Ponderosa Pine bears N55°30'W 33.46 ft.
Marked COR 5/MS 11 BT Nail in W. base.

Bearings taken with a staff compass declination
18 1/2° East per 1980 Isogonic chart.

Distances are pulled to 60d nails with brass
washers stamped L.S.1898 driven in the side
center of the bearing trees.


Monument stamped:

S.G.P. MS. 11

COR. 5

1982

O.R.L.S. 1898

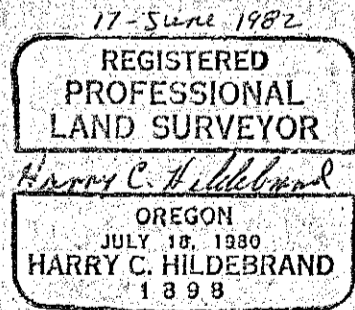

Office of..... County of..... Baker.....
State of... Oregon..... I hereby certify that the within instrument was filed in this office
for record on the..... day of....., 19.....
..... by
(COUNTY OFFICIAL) (DEPUTY)

Form R6-7100-57 (9/71)

FILED June 22, 1982
BAKER COUNTY SURVEYOR
SURVEY NO. 8-44-21