


CERTIFIED RECORD OF LAND CORNER MONUMENTATION

History of original corner establishment:

Corner originally established by W. Barr, under contract no. 388, dated May 7, 1881. Marked basalt rock 14"x8"x5" for 1/4 sec corner, from which; Pine 48" diam. bears S 78° W 31 lks dist. Pine 15" diam. bears N 60 1/2° W 52 lks dist.

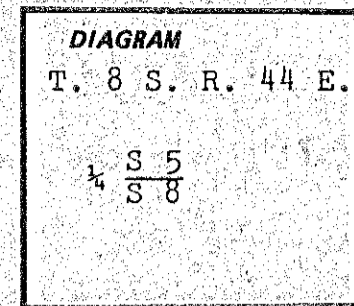

Description of corner evidence found:

Found no evidence of original stone. Found 48" burned out pine stump, scribed "BT" on lower blaze, S 78° W 31 lks distance. No evidence of northwest BT as area has all been burned off at one time.

Description of monument and accessories established to perpetuate the original location of this corner:

Set 2 1/2" x 30" aluminum pipe with 3 1/4" aluminum cap 24" in ground in mound of stone. Cap marked:

Bearing Trees

Ponderosa Pine 6" in diameter bears N 70° E 33.5 ft., scribed "1/4 S 5" in upper blaze and "BT" and brass tag stamped RLS 1664 in lower blaze.

Ponderosa Pine 9" in diameter bears S 31 1/2° W 93.0 ft., scribed "1/4 S 8" in upper blaze and "BT" and brass tag stamped RLS 1664 in lower blaze.

Compass declination 21° East

Note:

I set a guard post at corner with FS 54-4 sign, placed 54-3 and 54-4 signs on bearing trees and painted a red band at breast height on smoothed bark on bearing trees.

I hereby certify the above corner location was perpetuated as herein described on July 6, 1982.

Terry Butler, Witness

Frank Vaughn, Witness

T8SR44E
1/4 S 5 / 8
1982
RLS 1664

REGISTERED PROFESSIONAL LAND SURVEYOR

OREGON
JULY 14, 1978
CARL E. SUNDET
1664

Office of... County of... State of... I hereby certify that the within instrument was filed in this office for record on the... day of... 19... by (COUNTY OFFICIAL) (DEPUTY)

FILED July 13, 1982
BAKER COUNTY SURVEYOR
SURVEY NO. 8-44-22