


CERTIFIED RECORD OF LAND CORNER MONUMENTATION

History of original corner establishment:

Corner originally established by W. Barr, under contract no. 388, dated May 7, 1881.
Set stake 4 ft. long 4 in. diam. 18 in. in ground for 1/4 sec corner, from which;
Pine 20 in. diam. bears S 35° W 9 lks dist.
Pine 24 in. diam. bears N 25° W 94 lks dist.

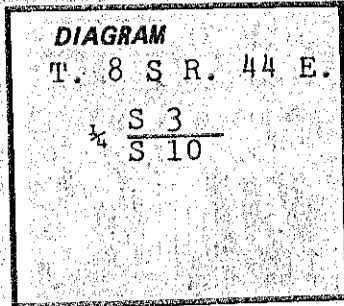

Description of corner evidence found:

Found remains of old squared post. Dug down approx. 12" to point of post. Hit rock at this depth. From which;
Pine stump N 25° W 94 lks to face. Scribed "BT" in lower blaze and unreadable scribing in upper blaze.
Root hole S 35° W 9 lks. No evidence of tree.

Description of monument and accessories established to perpetuate the original location of this corner:

Set 2 1/2" x 30" aluminum pipe with 3 1/4" aluminum cap 24" in ground in mound of stone. Cap marked: T8SR44E

Bearing Trees

Ponderosa Pine 11" in diameter bears N 36° E 22.6 ft., scribed "1/4 S3" in upper blaze and "BT" and brass tag stamped RLS 1664 in lower blaze.

Ponderosa Pine 10" in diameter bears S 72° E 34.5 ft., scribed "1/4 S10" in upper blaze and "BT" and brass tag stamped RLS 1664 in lower blaze.

Compass declination 21° 15' East

Note:

I set a guard post at corner with F.S. 54-4 sign, placed 54-3 and 54-4 signs on bearing trees and painted a red band at breast height on smoothed bark on bearing trees.

I hereby certify the above corner location was perpetuated as herein described on July 3, 1982.

Terry Butler Terry Butler, Witness

Frank Vaughn Frank Vaughn, Witness

REGISTERED
PROFESSIONAL
LAND SURVEYOR

Carl E. Sundet
OREGON
JULY 14, 1978
CARL E. SUNDET
1664

Office of..... County of.....
State of..... I hereby certify that the within instrument was filed in this office
for record on the..... day of....., 19.....
..... by
(COUNTY OFFICIAL) (DEPUTY)