

CERTIFIED RECORD OF LAND CORNER MONUMENTATION

History of original corner establishment:

Corner originally established by W. Barr under contract T.8S. R.44E. dated May 7, 1881, No. 388.

Set stake 4 ft. long 4 in. diam., 18 in. in ground for corner to sec. 2,3,10,11; from which;



Fir 36 in. diam. bears N 30° E 61ks dist.

Fir 15 in. diam. bears S 59° E 67 lks dist.

Pine 36 in. diam. bears S 87° W 64 lks dist.

Fir 20 in. diam. bears N 51° W 84 lks dist.

Re-monumented by BLM in 1974. Set an iron post, 28 ins. long, 2½ ins diam., 22 ins. in the ground, with brass cap mkd.

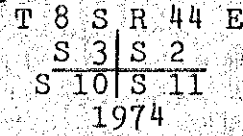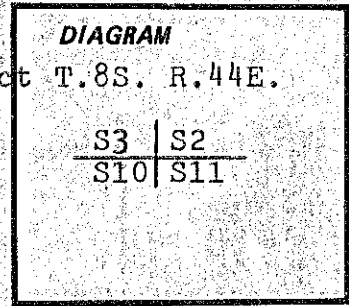

Description of corner evidence found:

Found BLM Brass Cap from which;

28 in. Fir with chopped open face, scribing visible but unreadable, S 55° E 66 lks dist.

14 in. Larch with partially healed face with scribing visible, N 43½° E 73 lks dist.

11 in. pine with healed face and scribing visible, N 14° W 101 lks dist.

14 in Larch, dead and down, scribing visible, N 74½° W 35 lks dist.

Decayed stump with visible scribing, N 30° E 6 lks dist.

Stump scribed "S10" N 89° W 64 lks dist.

Evidence of old stump, mostly gone N 47° W 84 lks dist.

Compass Declination 21°15'


Description of monument and accessories I established to perpetuate the original location of this corner:

The southwest bearing tree was dead and down. I scribed a 14" Larch, "T8SR44ES10" in upper blaze and "BT" and brass tag stamped RLS 1664 in lower blaze, S 68° W 136 lks dist.

I set a guard post at the corner with FS 54-4 signs. I painted a red band at breast height on smoothed bark on bearing trees and put F.S. 54-4 signs on bearing trees.

I hereby certify the above corner was perpetuated as herein described on July 3, 1982.

Terry Butler, Terry Butler, Witness
Frank Vaughn, Frank Vaughn, Witness

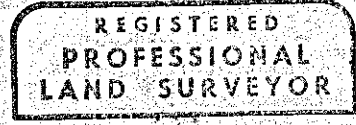

Carl E. Sundet
 OREGON
 JULY 14, 1978
 CARL E. SUNDET
 1664

Office of..... County of.....
 State of..... I hereby certify that the within instrument was filed in this office
 for record on the..... day of....., 19.....
 by
 (COUNTY OFFICIAL) (DEPUTY)