


CERTIFIED RECORD OF LAND CORNER MONUMENTATION

History of original corner establishment:

Corner originally established by W. Barr
under contract #388, dated May 7, 1881
Set 4" x 4' stake 18" in ground from which;
a Tamarack 24" in diameter bears N6°E, 28 lks
a Tamarack 18" in diameter bears S34°E, 19 lks

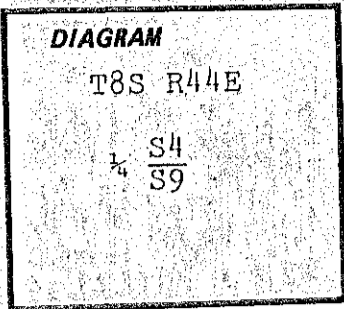

Description of corner evidence found:

Nothing found.

Set by single proportionate measurement

Description of monument and accessories established to perpetuate the original location of this corner:

Set 2½" x 30" aluminum pipe with ¾" aluminum cap
24" in ground in mound of stone, marked;



Bearing trees:

13" ponderosa pine - S68°W - 38.3' - scribed "¼ S9" in upper blaze and "BT" in lower blaze

11" douglas fir - N83°E - 47.3' - scribed "¼ S4" in upper blaze and "BT" in lower blaze

Compass declination 20° East

Note:

I set guard posts at corner with USFS 54-2 and 54-4 signs, placed USFS bearing tree signs on all bearing trees, painted red band on smoothed bark at breast height on all bearing trees. Placed brass tag stamped RLS 1664 in "BT" blaze.

I hereby certify the above corner location was perpetuated as herein described in August 1982.

Frank Vaughn Frank Vaughn, Witness



Office of..... County of.....
State of....., I hereby certify that the within instrument was filed in this office
for record on the..... day of....., 19.....
..... by
(COUNTY OFFICIAL) (DEPUTY)