


CERTIFIED RECORD OF LAND CORNER MONUMENTATION

History of original corner establishment:

Corner originally established by Walden under contract #198 dated July 1873

Set basalt stone 12"x10"x5'

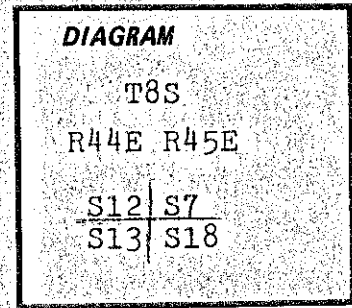


Description of corner evidence found:

Found 15"x11"x6" stone 4" in ground with 6 notches east & west, 2 notches north & 4 notches south

Description of monument and accessories I established to perpetuate the original location of this corner:

Set 2½" x 30" aluminum pipe with 3¼" aluminum cap 6" in ground to bedrock in large mound of stone, marked: Placed original stone in base of mound.

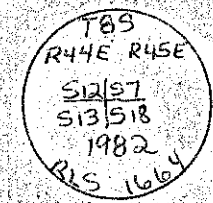

Accessories:

- 3½' x 2' mound of stone - N23°W - 10.4 ft.
- 3' x 2' mound of stone - N62½°E - 7.2 ft.
- 4' x 2' mound of stone - S17°E - 15.4 ft.
- 4' x 2' mound of stone - S55°W - 10.4 ft.

Compass declination 20.75° East

Note:

I set steel fence post 5' south of corner with USFS 54-9 sign, placed USFS bearing tree signs and attention signs in all mounds of stones.

I hereby certify the above corner was perpetuated as herein described in November 1982

REGISTERED
PROFESSIONAL
LAND SURVEYOR

OREGON
JULY 14, 1978
CARL E. SUNDET
1664

Office of..... County of.....
 State of....., I hereby certify that the within instrument was filed in this office
 for record on the..... day of....., 19.....
 by
 (COUNTY OFFICIAL) (DEPUTY)

FILED Dec 20 1982
 BAKER COUNTY SURVEYOR
 SURVEY NO. 8-44-29
8-45-52