


CERTIFIED RECORD OF LAND CORNER MONUMENTATION

History of original corner establishment:

Corner originally established by W. Barr under contract #388 dated May 1881

Set marked basalt rock 10"x10"x6" from which
a tamarack, 15" in diameter bears S73°E - 61 lks
a pine, 18" in diameter bears N11°W - 185 lks

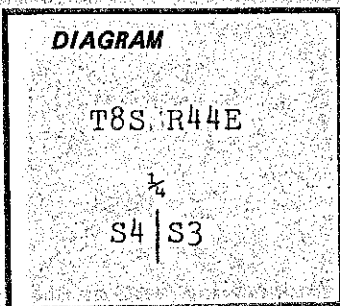


Description of corner evidence found:

Found 10"x10"x6" stone with ¼ on west face, firmly set, from which,
A pine, root wad and stump hole - N15°W - 185 lks
A tamarack rotted stump - S76°E - 61 lks

Description of monument and accessories established to perpetuate the original location of this corner:

Set 2½" x 30" aluminum pipe with ¾" aluminum cap 24" in ground in large mound of stone, marked:
Buried original stone alongside

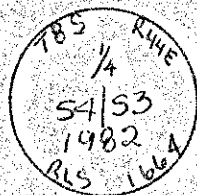

Bearing trees:

17½" ponderosa pine - N68.5°W - 49.5 ft. scribed "¼ S4" in upper blaze and "BT" and brass tag stamped RLS 1664 in lower blaze
18" ponderosa pine - N20.5°E - 84.4 ft. scribed "¼ S3" in upper blaze and "BT" and brass tag stamped RLS 1664 in lower blaze
Compass declination 20.75° East

Note:

Set steel fence post 5' north of corner with USFS 54-4 sign, placed USFS bearing tree signs on all bearing trees and painted red band at breast height on smoothed bark on all bearing trees.

I hereby certify the above corner was perpetuated as herein described in November 1982

REGISTERED
PROFESSIONAL
LAND SURVEYOR

Carl E. Sundet

OREGON
JULY 14, 1978
CARL E. SUNDET
1654

Office of..... County of.....
State of....., I hereby certify that the within instrument was filed in this office
for record on the..... day of....., 19.....
..... by

(COUNTY OFFICIAL) (DEPUTY)