


CERTIFIED RECORD OF LAND CORNER MONUMENTATION

History of original corner establishment:

None

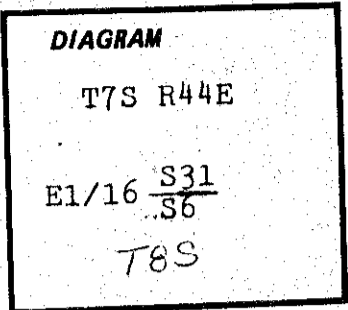

Description of corner evidence found:

None

Description of monument and accessories established to perpetuate the original location of this corner:

Set 2½" x 30" aluminum pipe with ¾" aluminum cap 27" in ground, marked:
No stones available for mound



Bearing trees:

10" ponderosa pine - N03°E - 32.7 ft. scribed "E1/16 S31" in upper blaze and "BT" and brass tag stamped RLS 1664 in lower blaze
6" ponderosa pine - S39.5°W - 42.0 ft. scribed "E1/16 S6" in upper blaze and "BT" and brass tag stamped RLS 1664 in lower blaze

Compass declination 20° East

Note:

I set steel fence post 5' west of corner with USFS 54-9 sign, placed USFS bearing tree signs on all bearing trees and painted red band at breast height on smoothed bark on all bearing trees.

I hereby certify the above corner was perpetuated as herein described in September 1982

**REGISTERED
PROFESSIONAL
LAND SURVEYOR**

Carl E. Sundet

OREGON
JULY 14, 1978
CARL E. SUNDET
1664

Office of..... County of.....
State of....., I hereby certify that the within instrument was filed in this office
for record on the..... day of....., 19.....
..... by.....
(COUNTY OFFICIAL) (DEPUTY)