


CERTIFIED RECORD OF LAND CORNER MONUMENTATION

History of original corner establishment:

Corner originally established by Walden under contract #198 dated July 1873.
Set red sandstone 12"x12"x5" 8" in ground

Corner retraced by W. Barr under contract #388 dated May 1881

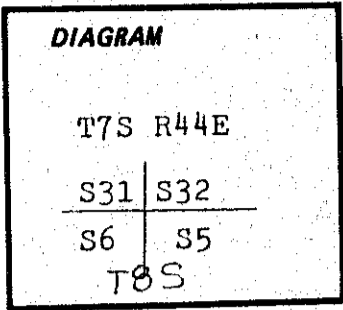


Description of corner evidence found:

None

Set by proportionate measurement

Description of monument and accessories established to perpetuate the original location of this corner:

Set 2½" x 30" aluminum pipe with ¾" aluminum cap 26" in ground marked:
No stones available for mound

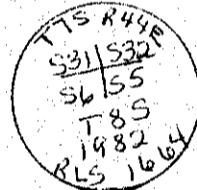

Bearing trees:

- 7" ponderosa pine - N20°W - 25.6 ft. scribed "T7S R44E S31" in upper blaze and "BT" and brass tag stamped RLS 1664 in lower blaze
- 12" ponderosa pine - N22.5°E - 114.7 ft. scribed "T7S R44E S32" in upper blaze and "BT" and brass tag stamped RLS 1664 in lower blaze
- 15" ponderosa pine - S25°E - 57.3 ft. scribed T8S R44E S5" in upper blaze and "BT" and brass tag stamped RLS 1664 in lower blaze
- 13" ponderosa pine - S53°W - 75.1 ft. scribed "T8S R44E S6" in upper blaze and "BT" and brass tag stamped RLS 1664 in lower blaze

Compass declination 20° East

Note:

I set steel fence post 5' north of corner with USFS 54-4 sign placed USFS bearing tree signs on all bearing trees and painted red band at breast height on smoothed bark on all bearing trees

I hereby certify the above corner was perpetuated as herein described in September 1982

Office of..... County of.....
 State of....., I hereby certify that the within instrument was filed in this office
 for record on the..... day of....., 19.....
 _____ by _____
 (COUNTY OFFICIAL) (DEPUTY)



FILED Dec 20 1982
 BAKER COUNTY SURVEYOR
 SURVEY NO. 7-44-63
8-44-36