


CERTIFIED RECORD OF LAND CORNER MONUMENTATION

History of original corner establishment:

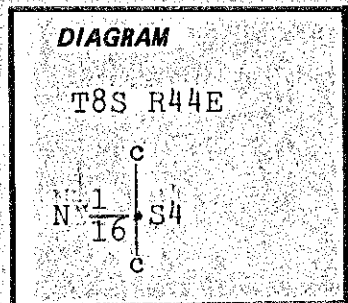

Description of corner evidence found:

Description of monument and accessories I established to perpetuate the original location of this corner:

Set 2½" x 30" aluminum pipe with ¾" aluminum cap 25" in ground in mound of stone, marked:



Bearing trees:

7" ponderosa pine - N88½°W - 98.6 ft. scribed "CN 1/16 S4" in upper blaze and "BT" and brass tag stamped RLS 1664 in lower blaze

10" ponderosa pine - S37½°W - 60.2 ft. scribed "CN 1/16 S4" in upper blaze and "BT" and brass tag stamped RLS 1664 in lower blaze

Compass declination 19 3/4° East

Note:

I set steel fence post 6' west with 54-9 sign, placed USFS bearing tree and 54-9 signs on all bearing trees and painted red band at breast height on smoothed bark on all bearing trees.

I hereby certify the above corner was perpetuated as herein described in May 1983.

Witness: Ron Horton

REGISTERED
PROFESSIONAL
LAND SURVEYOR

Carl E. Sundet

OREGON
JULY 14, 1978
CARL E. SUNDET
1664

Office of..... County of.....
 State of..... I hereby certify that the within instrument was filed in this office
 for record on the..... day of....., 19.....
 by
 (COUNTY OFFICIAL) (DEPUTY)

Form R6-7100-57 (9/71)

FILED July 25, 1983
 BAKER COUNTY SURVEYOR
 SURVEY NO. 8-44-38