


CERTIFIED RECORD OF LAND CORNER MONUMENTATION


History of original corner establishment:

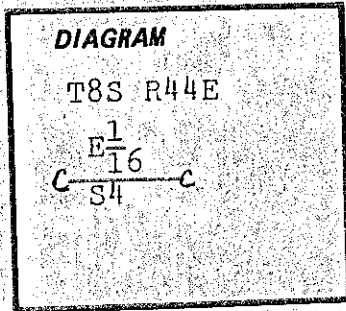

Description of corner evidence found:

Description of monument and accessories established to perpetuate the original location of this corner:

Set 2½" x 30" aluminum pipe with ¾" aluminum cap 26" in ground in mound of stone, Marked:

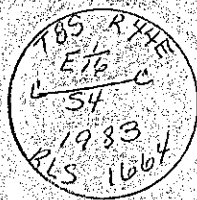

Bearing trees:

11" douglas fir - N22¼°E - 31.6 ft. scribed "CE 1/16 S4" in upper blaze and "BT" and brass tag stamped RLS 1664 in lower blaze

7" douglas fir - S25°W - 32.2 ft. scribed "CE 1/16 S4" in upper blaze and "BT" and brass tag stamped RLS 1664 in lower blaze

Compass declination 19 3/4° East

Note:

I set steel fence post 6' west of corner with 54-9 sign, placed USFS bearing tree and 54-9 signs on all bearing trees and painted red band at breast height on smoothed bark on all bearing trees.

I hereby certify the above corner was perpetuated as herein described in May 1983.

Witness: Ron Horton

REGISTERED
PROFESSIONAL
LAND SURVEYOR

Carl E. Sundet

OREGON
JULY 14, 1978
CARL E. SUNDET
1664

Office of..... County of.....
 State of....., I hereby certify that the within instrument was filed in this office
 for record on the..... day of....., 19.....
 by
 (COUNTY OFFICIAL) (DEPUTY)