


CERTIFIED RECORD OF LAND CORNER MONUMENTATION

History of original corner establishment:

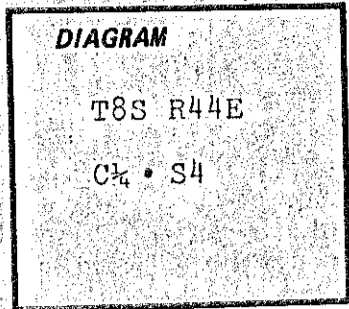

Description of corner evidence found:

Description of monument and accessories established to perpetuate the original location of this corner:

Set 2 $\frac{1}{2}$ " x 30" aluminum pipe with 3 $\frac{1}{4}$ " aluminum cap 26" in ground in mound of stone, marked:



Bearing trees:

- 8" ponderosa pine - N39 $\frac{1}{2}$ °E - 33.2 ft. scribed "C $\frac{1}{4}$ S4" in upper blaze and "BT" and brass tag stamped RLS 1664 in lower blaze
- 7" ponderosa pine - S04 $\frac{1}{2}$ °E - 25.9 ft. scribed "C $\frac{1}{4}$ S4" in upper blaze and "BT" and brass tag stamped RLS 1664 in lower blaze


Compass declination 19 3/4° East

Note:

I set steel fence post 6' south of corner with 54-9 sign, placed USFS bearing tree and 54-9 signs on all bearing trees and painted red band at breast height on smoothed bark on all bearing trees.

I hereby certify the above corner was perpetuated as herein described in May 1983

Witness: Ron Horton

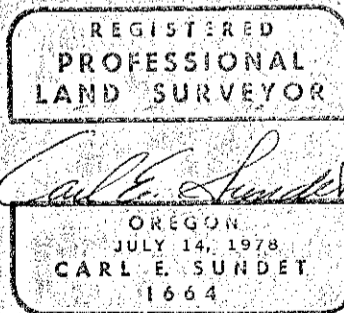

Office of..... County of.....
 State of..... I hereby certify that the within instrument was filed in this office
 for record on the..... day of....., 19.....
 by
 (COUNTY OFFICIAL) (DEPUTY)