


CERTIFIED RECORD OF LAND CORNER MONUMENTATION

History of original corner establishment:

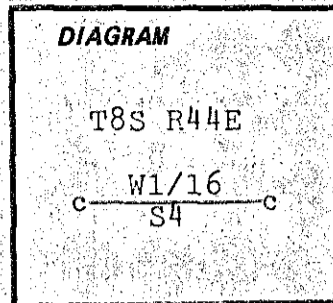

Description of corner evidence found:

Description of monument and accessories established to perpetuate the original location of this corner:

Set 2 1/2" x 30" aluminum pipe with 3/4" aluminum cap 26" in ground, marked: No stones available for mound.



Bearing trees:

7" ponderosa pine - N80 3/4° W - 61.8 ft. scribed "CW 1/16 S4" in upper blaze and "BT" and brass tag stamped RLS 1664 in lower blaze  
13" ponderosa pine - N46° E - 36.1 ft. scribed "CW 1/16 S4" in upper blaze and "BT" and brass tag stamped RLS 1664 in lower blaze  
Compass declination 19 3/4° East

Note:

I set a steel fence post 6' west of corner with USFS 54-9 sign, placed USFS bearing tree and 54-9 signs on all bearing trees and painted red band at breast height on smoothed bark on all bearing trees.

I hereby certify the above corner was perpetuated as herein described in May 1983.

Witness: Ron Horton

REGISTERED PROFESSIONAL LAND SURVEYOR

Carl E. Sundet  
OREGON  
JULY 14, 1978  
CARL E. SUNDET  
1664

Office of..... County of.....  
State of....., I hereby certify that the within instrument was filed in this office  
for record on the..... day of....., 19.....  
..... by .....  
(COUNTY OFFICIAL) (DEPUTY)

Form R6-7100-57 (9/71)

FILED July 25, 1983  
BAKER COUNTY SURVEYOR  
SURVEY NO. 8-44-41

U.S. GPO-798-276