

CERTIFIED RECORD OF LAND CORNER MONUMENTATION

History of original corner establishment:


Corner originally established by Barr under contract #388 dated 1881.

Set marked basalt rock 12" x 10" x 5" from which;
a pine 15" in diameter bears N54°E - 55 lks
a pine 24" in diameter bears N24°W - 95 lks

Corner remonumented by the BLM in 1974;

Set 2 1/2" x 28" iron post with brass cap, and referenced:

a 10" ponderosa pine - S83°E - 17 lks scribed
" 1/4 S4 BT"
a 12" ponderosa pine - N60°W - 9 lks scribed " 1/4 S5 BT"

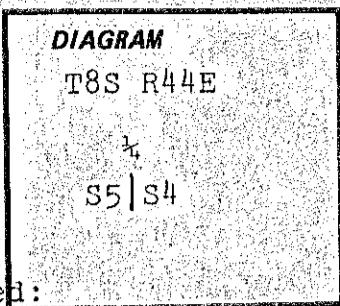

Description of corner evidence found:

Found standard BLM brass cap, marked:

Bearing trees:

a 13" ponderosa pine - N63°W - 9 lks - healed blaze
some visible scribe marks
a 20" ponderosa pine stump - S54°W - 55 lks - scribe
marks 1/4 S visible
a 31" ponderosa pine stump - S28°E - 95 lks - scribe
marks BT visible
a 11" ponderosa pine - S79°E - 17 lks - scribed 1/4 S4 BT



Compass declination 20° East

Description of monument and accessories established to perpetuate the original location of this corner:

Note:

I placed USFS bearing tree and attention signs on all bearing trees and painted red band at breast height on smoothed bark on all bearing trees. I set steel fence post 5' south of corner with USFS 54-4 sign. I hereby certify the above corner was perpetuated as herein described in June 1982

REGISTERED
PROFESSIONAL
LAND SURVEYOR

OREGON
JULY 14, 1978
CARL E. SUNDET
1664

Office of..... County of.....
State of....., I hereby certify that the within instrument was filed in this office
for record on the..... day of....., 19.....
..... by

(COUNTY OFFICIAL)

(DEPUTY)

Form R6-7100-57 (9/71)

FILED July 25, 1983
BAKER COUNTY SURVEYOR
SURVEY NO. 8-44-43