


CERTIFIED RECORD OF LAND CORNER MONUMENTATION

History of original corner establishment:

Corner originally established by Barr under contract #388 dated 1881, Set 4" x 4' stake 18" in ground, from which:

- a 36" pine bears N19°E - 75 lks
- a 20" pine bears N33°W - 183 lks
- a 18" pine bears S14°W - 75 lks
- a 30" pine bears S10°E - 100 lks

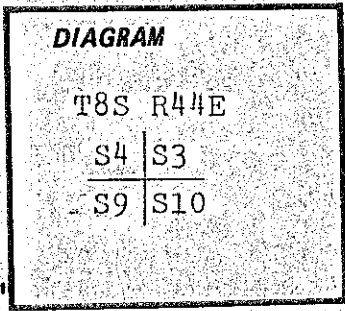

Corner remonumented by the BLM in 1974, set 2½" x 28" iron post with brass cap, and referenced:

- a 16" ponderosa pine - N20°E - 38 lks - scribed T8SR44E S3 BT
- a 12" ponderosa pine - S80°E - 48 lks - scribed T8SR44E S10 BT
- a 12" ponderosa pine - S31°W - 48½ lks - scribed T8SR44E S9 BT
- a 10" ponderosa pine - N42°W - 78 lks - scribed T8SR44E S4 BT

Description of corner evidence found:


Found standard BLM brass cap marked:

Bearing trees:

- 23" ponderosa pine - N31°W - 183 lks - scribing visible
- 12" ponderosa pine - N40°W - 78 lks - partially healed face scribing visible
- 14" ponderosa pine - S32°W - 48 lks - partially healed face scribing visible
- Root hole - S16°W - 79 lks
- Root hole - S08½°E - 103 lks
- 14" ponderosa pine - S78°E - 48 lks - partially healed face scribing visible
- Decayed stump - N23°30'E - 75 lks
- 19" ponderosa pine - N22°E - 38 lks - partially healed face scribing visible

Compass declination 21°20' East

Description of monument and accessories established to perpetuate the original location of this corner:

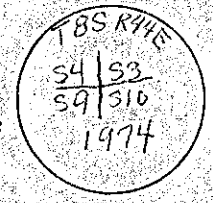

Note:

I placed USFS bearing tree and attention signs on all bearing trees and painted red band at breast height on smoothed bark on all bearing trees. I set steel fence post 5' from corner with USFS 54-4 sign. I hereby certify the above corner was perpetuated as herein described in June 1982

REGISTERED  
PROFESSIONAL  
LAND SURVEYOR

*Carl E. Sundet*

OREGON  
JULY 14, 1978  
CARL E. SUNDET  
1664

Office of..... County of.....

State of....., I hereby certify that the within instrument was filed in this office

for record on the..... day of....., 19.....

..... by .....  
(COUNTY OFFICIAL) (DEPUTY)

FILED July 25, 1983

BAKER COUNTY SURVEYOR

SURVEY NO. B-44-44