

CERTIFIED RECORD OF LAND CORNER MONUMENTATION



History of original corner establishment:

Corner originally established by Barr under contract #388 dated 1881, Set 4" x 4" stake 18" in ground from which:

- a 24" pine bears N55 $\frac{1}{2}$ ^oW - 38 lks
- a 30" pine bears N32 $\frac{1}{2}$ ^oE - 45 lks

Corner remonumented by the BLM in 1974, set 2 $\frac{1}{2}$ " x 28" iron post with brass cap and referenced:

- a 13" ponderosa pine - S59^oE - 27 $\frac{1}{2}$ lks marked $\frac{1}{4}$ S2 BT
- a 7" fir - N58^oW - 36 lks marked $\frac{1}{4}$ S3 BT

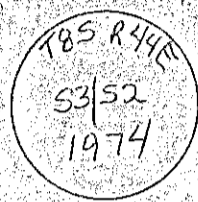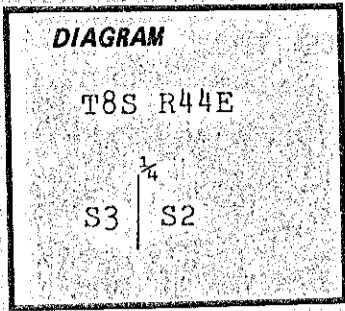

Description of corner evidence found:

Found standard BLM brass cap, marked:

Bearing trees:

- 14" ponderosa pine - S52^oE - 27 $\frac{1}{2}$ lks scribed $\frac{1}{4}$ S2 BT
- 36" ponderosa pine snag - N40 $\frac{1}{2}$ ^oE - 46 lks scribing visible
- 7" fir - N51 $\frac{1}{2}$ ^oW - 36 lks scribed $\frac{1}{4}$ S3 BT
- Old stump - N43^oW - 38 $\frac{1}{2}$ lks - illegible scribing

Compass declination 25^o East

Description of monument and accessories established to perpetuate the original location of this corner:

Note:

I placed USFS bearing tree and attention signs on all bearing trees and painted red band on smoothed bark at breast height on all bearing trees. I set steel fence post 5' from corner with USFS 54-4 sign. I hereby certify the above corner was perpetuated as herein described in July 1982.

REGISTERED
PROFESSIONAL
LAND SURVEYOR

Carl E. Sundet

OREGON
JULY 14, 1978
CARL E. SUNDET
1664

Office of..... County of.....
 State of..... I hereby certify that the within instrument was filed in this office
 for record on the..... day of..... 19.....
 by.....
 (COUNTY OFFICIAL) (DEPUTY)