

CERTIFIED RECORD OF LAND CORNER MONUMENTATION


History of original corner establishment:

Corner originally established by Barraunder contract #388 dated 1881, set marked basalt rock 12"x12"x8" from which:

- a 15" pine bears S26°E - 15 lks
- a 15" pine bears S66°W - 33 lks
- a 30" pine bears N22°W - 63 lks
- a 24" pine bears N68°E - 118 lks

Corner remonumented by the BLM in 1974, set 2½" x 28" iron post with brass cap and referenced

- 6" ponderosa pine - N89°E - 16 lks marked T8SR44E S5 BT
- 6" ponderosa pine - N55°W - 10½ lks marked T8SR44E S6 BT

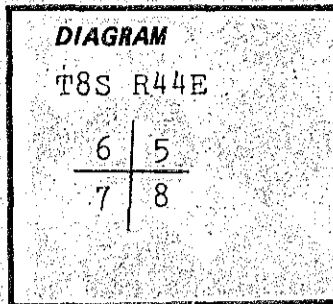

Description of corner evidence found:

Found standard BLM brass cap marked:

Bearing trees:

- a 17" ponderosa pine - S26°E - 15 lks
- a 21" ponderosa pine - S69°W - 33 lks
- a 28" ponderosa pine - N16°W - 63 lks - dead
- a 26" ponderosa pine - N68°E - 118 lks - dead & down
- a 6" ponderosa pine - N89°E - 16 lks
- a 6" ponderosa pine - N55°W - 10½ lks



Compass declination 20° East

Description of monument and accessories I established to perpetuate the original location of this corner:

Note:

I placed USFS bearing tree and attention signs on all bearing trees and painted red band on smoothed bark at breast height on all bearing trees. I set steel fence post 5' from corner with USFS 54-4 sign. I hereby certify the above corner was perpetuated as herein described in May 1982.

REGISTERED  
PROFESSIONAL  
LAND SURVEYOR

*Carl E. Sundet*

OREGON  
JULY 14, 1978  
CARL E. SUNDET  
1664

Office of..... County of.....  
 State of....., I hereby certify that the within instrument was filed in this office  
 for record on the..... day of....., 19.....  
 ..... by .....  
 (COUNTY OFFICIAL) (DEPUTY)

Form R6-7100-57 (9/71)

FILED July 25, 1983  
 BAKER COUNTY SURVEYOR  
 SURVEY NO. 8-44-46

☆ GPO-798-276