


CERTIFIED RECORD OF LAND CORNER MONUMENTATION

History of original corner establishment:

Corner originally established by Barr under contract #388 dated 1881, set marked basalt rock 12"x10"x5" from which: a pine 18" in diameter bears S26 1/2° E - 56 lks a pine 36" in diameter bears S8 1/2° W - 107 lks a pine 30" in diameter bears N20° W - 160 lks a pine 20" in diameter bears N78° E - 118 lks

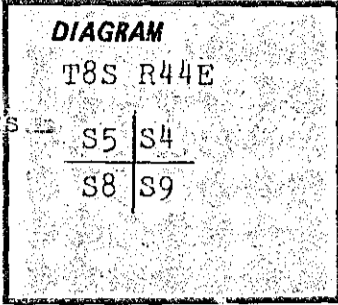

Corner remonumented by the BLM in 1974, set 2 1/2" x 28" iron post with brass cap, and referenced: a 8" ponderosa pine - S4° E - 20 lks - scribed T8SR44E S9 BT a 13" ponderosa pine - N43 1/2° W - 36 lks - scribed T8SR44E S5 BT

Description of corner evidence found:

Found standard BLM brass cap, marked: Bearing trees:

- 14" ponderosa pine - N43 1/2° W - 36 lks - scribible visible
43" ponderosa pine - S12° W - 108 lks - visible scribe marks
8" ponderosa pine - S2° E - 20 lks - scribible visible
Root hole - uprooted tree - possible BT - S26 1/2° E - 56 lks no scribible visible
26" ponderosa pine - N79 1/2° E - 116 lks - chopped out face
37" ponderosa pine stump - N18° W - 160 lks



Description of monument and accessories established to perpetuate the original location of this corner:

Bearing tree: 12" ponderosa pine - N31° W - 50.7 ft. Scribed "T8SR44E S5" in upper blaze and "BT" and brass tag stamped RLS 1664 in lower blaze

Compass declination 20° East

Note:

I placed USFS attention and bearing tree signs on all bearing trees and painted red band on smoothed bark at breast height on all bearing trees. I set steel fence post 5' from corner with USFS 54-4 sign. I hereby certify the above corner was perpetuated as herein described in May 1983.

REGISTERED PROFESSIONAL LAND SURVEYOR

Signature: Carl E. Sundet
OREGON JULY 14, 1978 CARL E. SUNDET 1664

Office of... County of... State of... I hereby certify that the within instrument was filed in this office for record on the... day of... 19... by (COUNTY OFFICIAL) (DEPUTY)

Form R6-7100-57 (9/71)

FILED July 25, 1983 BAKER COUNTY SURVEYOR SURVEY NO. 8-44-47