


CERTIFIED RECORD OF LAND CORNER MONUMENTATION

History of original corner establishment:

Corner originally established by Walden under contract #198 dated July 1873.

Set granite rock 14" x 8" x 6" 8" in ground.

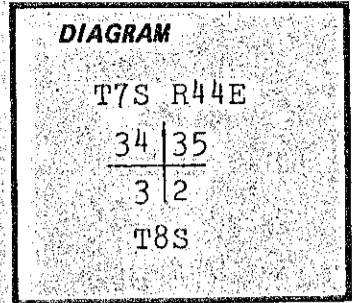

Description of corner evidence found:

No evidence of original stone.
Set by single proportionate measurement

Description of monument and accessories established to perpetuate the original location of this corner:

Set 2½" x 30" aluminum pipe with ¾" aluminum cap 12" in ground in mound of stones, marked:



Bearing tree:

20" ponderosa pine - S79°E - 14.4 ft. scribed "T8SR44E S2" in upper blaze and "BT" and brass tag stamped RLS 1664 in lower blaze

Accessories:

- 3'x2' mound of stone - S28½°W - 37.4 ft.
- 3'x2' mound of stone - N46°W - 32.3 ft.
- 3'x2' mound of stone - N4 ¾°E - 39.1 ft.

Compass declination 19 ¾° East

Note:

I set steel fence post 6' east of corner with USFS 54-4 sign, placed USFS bearing tree and attention signs on bearing tree and in mounds of stone and painted red band on smoothed bark at breast height on bearing tree.

I hereby certify the above corner was perpetuated as herein described in June 1983.

Witness: Dave Edwards
Ron Horton

REGISTERED
PROFESSIONAL
LAND SURVEYOR

Carl E. Sundet

OREGON
JULY 14, 1978
CARL E. SUNDET
1664

Office of..... County of.....
State of..... I hereby certify that the within instrument was filed in this office
for record on the..... day of....., 19.....

(COUNTY OFFICIAL)

(DEPUTY)

FILED July 25 1983
BAKER COUNTY SURVEYOR
SURVEY NO. 7-44-70
8-44-49