


CERTIFIED RECORD OF LAND CORNER MONUMENTATION

History of original corner establishment:

Corner originally established by Walden under contract #198 dated July 1873.

Set quartz rock 10" x 9" x 9" 5" in ground

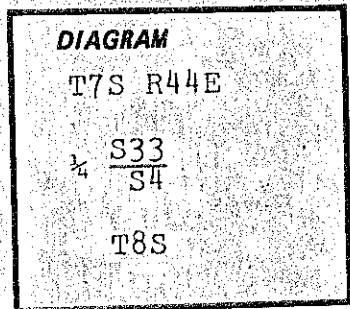

Description of corner evidence found:

No evidence of original stone.
Set by single proportionate measurement.

Description of monument and accessories established to perpetuate the original location of this corner:

Set 2½" x 30" aluminum pipe with ¾" aluminum cap 24" in ground in small mound of stone, marked:



Bearing trees:

11" ponderosa pine - N69½°W - 41.4 ft. scribed "¾ S33" in upper blaze and "BT" and brass tag stamped RLS 1664 in lower blaze

9" ponderosa pine - S59½°E - 67.8 ft. scribed "¾ S4" in upper blaze and "BT" and brass tag stamped RLS 1664 in lower blaze

Compass declination 19½° East

Note:

I set steel fence post west of corner with USFS 54-4 sign, placed USFS bearing tree and attention signs on all bearing trees and painted red band at breast height on smoothed bark on all bearing trees.

I hereby certify the above corner was perpetuated as herein described in May 1983.

Witness: Ron Horton

REGISTERED
PROFESSIONAL
LAND SURVEYOR

Carl E. Sundet

OREGON
JULY 14, 1978
CARL E. SUNDET
1564

Office of..... County of.....
State of....., I hereby certify that the within instrument was filed in this office
for record on the..... day of....., 19.....

..... by
(COUNTY OFFICIAL) (DEPUTY)