


CERTIFIED RECORD OF LAND CORNER MONUMENTATION

History of original corner establishment:

Corner originally established by Walden under contract #198 dated July 1873

Set granite stone 14" x 10" x 5" 8" in ground.

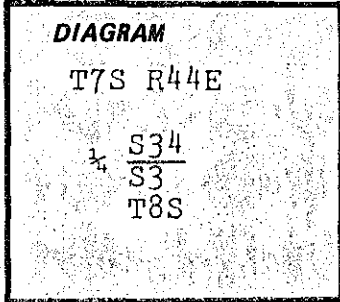

Description of corner evidence found:

No evidence of original stone.
Set by single proportionate measurement.

Description of monument and accessories established to perpetuate the original location of this corner:

Corner point falls on large boulder unsuitable for rock cap. Chisled "X" and painted red circle at true corner position. Set witness corner 7' west on line.

Set 2 1/2" x 30" aluminum pipe with 3/4" aluminum cap 8" in ground to bedrock, in large mound of stone, for witness corner, marked:



Bearing trees:

9" douglas fir - N11 1/2° E - 17.0 ft. scribed "¼ S34 WC" in upper blaze and "BT" and brass tag stamped RLS 1664 in lower blaze
13" ponderosa pine - S65° E - 50.9 ft. scribed "¼ S3 WC" in upper blaze and "BT" and brass tag stamped RLS 1664 in lower blaze

Compass declination 19 3/4° East

Note:

I set steel fence post 6' west of witness corner with USFS 54-4 sign, placed USFS bearing tree and attention signs on all bearing trees and painted red band at breast height on smoothed bark on all bearing trees.

I hereby certify the above corner was perpetuated as herein described in June 1983.

Witness: Ron Horton

REGISTERED
PROFESSIONAL
LAND SURVEYOR

Carl E. Suedel
JULY 14, 1983
CARL E. SUEDEL

Office of..... County of.....
State of....., I hereby certify that the within instrument was filed in this office
for record on the..... day of....., 19.....
..... by
(COUNTY OFFICIAL) (DEPUTY)

Form R6-7100-57 (9/71)

☆ GPO-798-276

FILED July 25 1983
DAKER COUNTY SURVEYOR
SURVEY NO. 7-44-65
B-44-54