


CERTIFIED RECORD OF LAND CORNER MONUMENTATION

History of original corner establishment:

Corner originally established by Walden under contract #198 dated July 1873

Set granite stone 16" x 8" x 6"

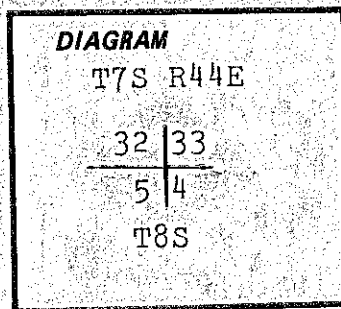

Description of corner evidence found:

No evidence of original stone

Unrecorded bearing trees:

- 24" douglas fir - S58°E - 42.2 ft. scribed T8SR44E S4
- 27" doullas fir - N83°W - 65.8 ft. scribed T7SR44E S32


Corner set by unrecorded BT's and call to sparta ditch 9 chains west

Description of monument and accessories established to perpetuate the original location of this corner:

Set 2½" x 30" aluminum pipe with ¾" aluminum cap 12" in ground in large mound of stone, marked:

Bearing trees:

- 12" ponderosa pine - N53°W - 54.6 ft. scribed "T7SR44E S32" in upper blaze and "BT" and brass tag stamped RLS 1664 in lower blaze
 - 13" ponderosa pine - S80 ¾°W - 82.4 ft. scribed "T8SR44E S5" in upper blaze and "BT" and brass tag stamped RLS 1664 in lower blaze
 - 17" ponderosa pine - S17°E - 74.0 ft. scribed "T8SR44E S4" in upper blaze and "BT" and brass tag stamped RLS 1664 in lower blaze
 - 9" ponderosa pine - N28½°E - 47.2 ft. scribed "T7SR44E S33" in upper blaze and "BT" and brass tag stamped RLS 1664 in lower blaze
- Compass declination 19½° East

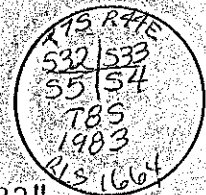

Note:

I set steel fence post 6' east of corner with USFS 54-4 sign, placed USFS bearing tree and attention signs on all bearing trees and painted red band on smoothed bark at breast height on all bearing trees.

I hereby certify the above corner was perpetuated as herein described in May 1983

Witness: Ron Horton

**REGISTERED
PROFESSIONAL
LAND SURVEYOR**

Carl E. Sundet

OREGON
JULY 14, 1978
CARL E. SUNDET
1664

Office of..... County of.....
State of..... I hereby certify that the within instrument was filed in this office
for record on the..... day of....., 19.....
..... by
(COUNTY OFFICIAL) (DEPUTY)

Form R6-7100-57 (9/71)

AMMENDED
FILED July 28, 1983
BAKER COUNTY SURVEYOR
SURVEY NO. 7-44-64A
8-44-55A