


CERTIFIED RECORD OF LAND CORNER MONUMENTATION

History of original corner establishment:  
Corner originally established by Walden under contract #198 dated July 1873  
Set basalt rock 14" x 8" x 6" 8" in ground.

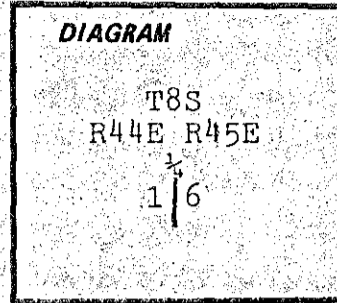

Description of corner evidence found:  
No evidence of original stone.  
Set by single proportionate measurement

Description of monument and accessories established to perpetuate the original location of this corner:  
Set 2 1/2" x 30" aluminum pipe with 3/4" aluminum cap 15" in ground in mound of stone, marked:



Bearing trees:  
21" ponderosa pine - S75°W - 120.0 ft. scribed "1/4 S1" in upper blaze and "BT" and brass tag stamped RLS 1664 in lower blaze  
34" ponderosa pine - N73°E - 206.2 ft. scribed "1/4 S6" in upper blaze and "BT" and brass tag stamped RLS 1664 in lower blaze  
Compass declination 19 3/4° East

Note:  
I set steel fence post 6' north of corner with USFS 54-4 sign, placed USFS bearing tree and attention signs on all bearing trees and painted red band on smoothed bark at breast height on all bearing trees.

I hereby certify the above corner was perpetuated as herein described in June 1983.  
Witness: Ron Horton

REGISTERED  
PROFESSIONAL  
LAND SURVEYOR

*Carl E. Sundet*

OREGON  
JULY 14, 1978  
CARL E. SUNDET

Office of..... County of.....  
State of..... I hereby certify that the within instrument was filed in this office  
for record on the..... day of....., 19.....  
..... by .....

(COUNTY OFFICIAL)

(DEPUTY)

Form R6-7100-57 (9/71)

FILED July 25 1983  
BAKER COUNTY SURVEYOR  
SURVEY NO. 8-44-41  
8-45-53

☆ GPO-798-276