

CERTIFIED RECORD OF LAND CORNER MONUMENTATION

History of original corner establishment:


Original survey executed in Sept. 1890 by Emil F. Voigt under instructions dated Aug. 29, 1980.

Set post 4½' long, 4" square, 12" in ground with mound of stone marked "Cor. 1 UQC S220" from which:

20" pine bears S89E 19.0'

21" pine bears N41E 18.5'

Both scribed "Cor. 1 UQC S220 BT"

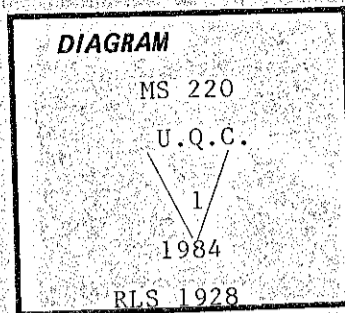

Description of corner evidence found:

Found 2" pipe at corner location.

Found 24" high cut stump N.81°W 18.5' with painted scar and 54-3 & 54-4 tags attached.

Found 28" stump with fallen tree and scar S.89°E. 19.0' and 54-3 & 54-4 tags attached.

Description of monument and accessories established to perpetuate the original location of this corner:

Set 30" long aluminum pipe with 3¼" aluminum cap, marked as shown above, 4" above ground. Steel post with signs 54-9 & 54-2 set next to cap.

Scribed:

7" pine N.27°W. 33.5' "1 UQC S220 BT"

8½" pine N.61°E. 35.4' "1 UQC S220 BT"

Attached signs 54-9 & 54-3 and nailed aluminum washers stamped "RLS 1928" by "BT" scribe on new trees. Painted blazes red and a 6" red band around all trees.

REGISTERED
PROFESSIONAL
LAND SURVEYOR

1-20-86
Duane Fehringer
OREGON
JULY 13, 1984
DUANE FEHRINGER
2118

Office of..... County of.....
State of....., I hereby certify that the within instrument was filed in this office
for record on the..... day of....., 19.....

..... by
(COUNTY OFFICIAL) (DEPUTY)