


CERTIFIED RECORD OF LAND CORNER MONUMENTATION

History of original corner establishment:

Original survey executed in Sept. 1890 by Emil F. Voigt under instructions dated Aug. 29, 1890.

Set a post 4½' long, 4" square, 12" in the ground with mound of stone, marked "Cor. No. 3, UQC S220" from which a rock 26"x28" base, 15" above ground bears N89W 98' distance marked with a cross.

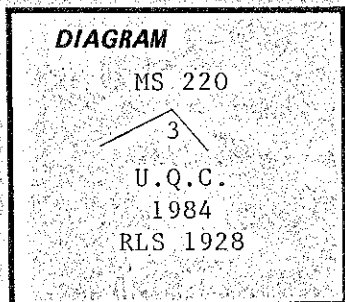

Description of corner evidence found:

Found original bearing object - 26"x28" rock with "X" on top N89W 98'
Re-established corner position from this B.O.

Description of monument and accessories established to perpetuate the original location of this corner:

Set 30" long aluminum pipe with 3½" aluminum cap, marked as shown above, 8" above ground in rock collar. Steel post with 54-9 and 54-2 signs set next to cap.

Scribed:

15" pine S.13°E. 48.5' "3 U.Q.C. 220 BT"

Painted original bearing object red.

Attached signs 54-9 & 54-3 and nailed aluminum washer stamped "RLS 1928" by "BT" scribe on new tree. Painted blaze red and a 6" red band around tree.

REGISTERED
PROFESSIONAL
LAND SURVEYOR
1-20-86
Duane Fehring
OREGON
JULY 13, 1984
DUANE FEHRINGER
2118

Office of..... County of.....

State of....., I hereby certify that the within instrument was filed in this office

for record on the..... day of....., 19.....

..... by

(COUNTY OFFICIAL)

(DEPUTY)

FILED May 9, 1986

BAKER COUNTY SURVEYOR

SURVEY NO. 8-44-73