


CERTIFIED RECORD OF LAND CORNER MONUMENTATION

History of original corner establishment:

Original survey executed in Sept. 1890 by Emil F. Voigt under instructions dated Aug. 29, 1980.

Set a post 4½' long, 4" square, 12" in ground with mound of stone marked "Cor. 4 UQC S220" from which:  
20" pine bears S4½°W 15½'  
24" pine bears S9½°W 24'  
Both marked "Cor. 4 UQC S220 BT"

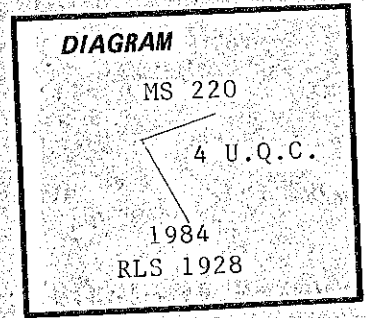

Description of corner evidence found:

Found 20" stump with 54-3 tag and painted "BT"

Description of monument and accessories established to perpetuate the original location of this corner:

Set 30" long aluminum pipe with ¾" aluminum cap marked as shown above, 4" above ground. Steel post with signs 54-9 & 54-2 set next to cap.

Scribed:

- 9" pine N.05°E. 23.8' "4 U.Q.C. S220 BT"
- 8" pine S.33°W. 27.0' "4 U.Q.C. S220 BT"

Attached signs 54-9 & 54-3 and nailed aluminum washers stamped "RLS 1928" by "BT" scribe on each new tree. Painted blazes red and a 6" red band around both trees.

REGISTERED PROFESSIONAL LAND SURVEYOR  
1-20-86  
*Duane Fehringer*  
OREGON  
JULY 13, 1984  
DUANE FEHRINGER  
2118

Office of..... County of.....  
State of..... I hereby certify that the within instrument was filed in this office  
for record on the..... day of....., 19.....  
..... by ..... (DEPUTY)  
(COUNTY OFFICIAL)